


EXHIBIT

G – Part II

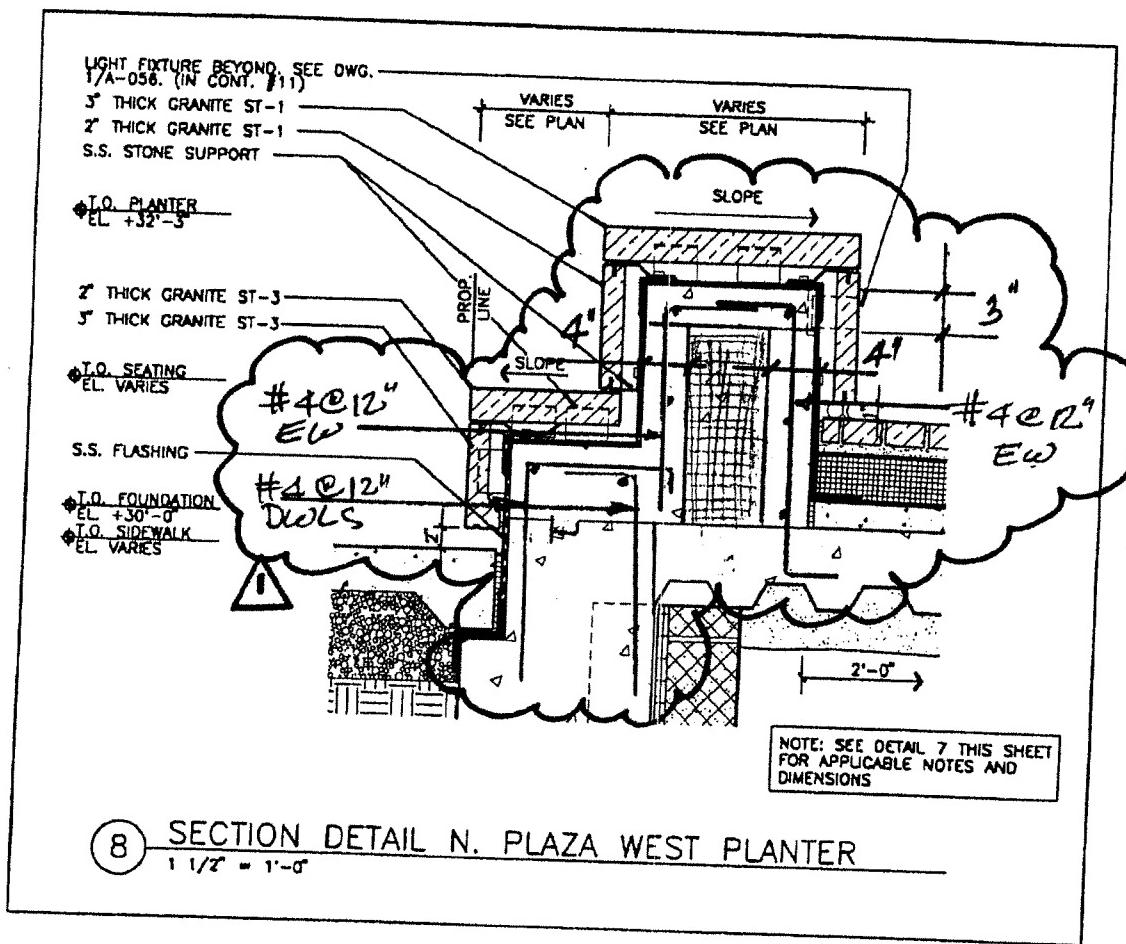

Baruch Academic Complex - Site B

55 Lexington Avenue

NEW YORK, NY 10010

OWNER

EDUCATIONAL AUTHORITY OF THE STATE OF NEW YORK, DA# 6500 1602 2178
1 PENNSYLVANIA PLAZA

NEW YORK, NY 10119

ARCHITECT
KPF ASSOCIATES
11 WEST 57TH STREET
NEW YORK, NY 10019

REF. DETAIL/SHEET NO.

8/A-053

SKETCH NO.

1295

NO.

REVISION


DATE

ADDENDUM #2 (CONTRACT #16)

6/5/98

SCALE

3 1/4" = 1'-0"

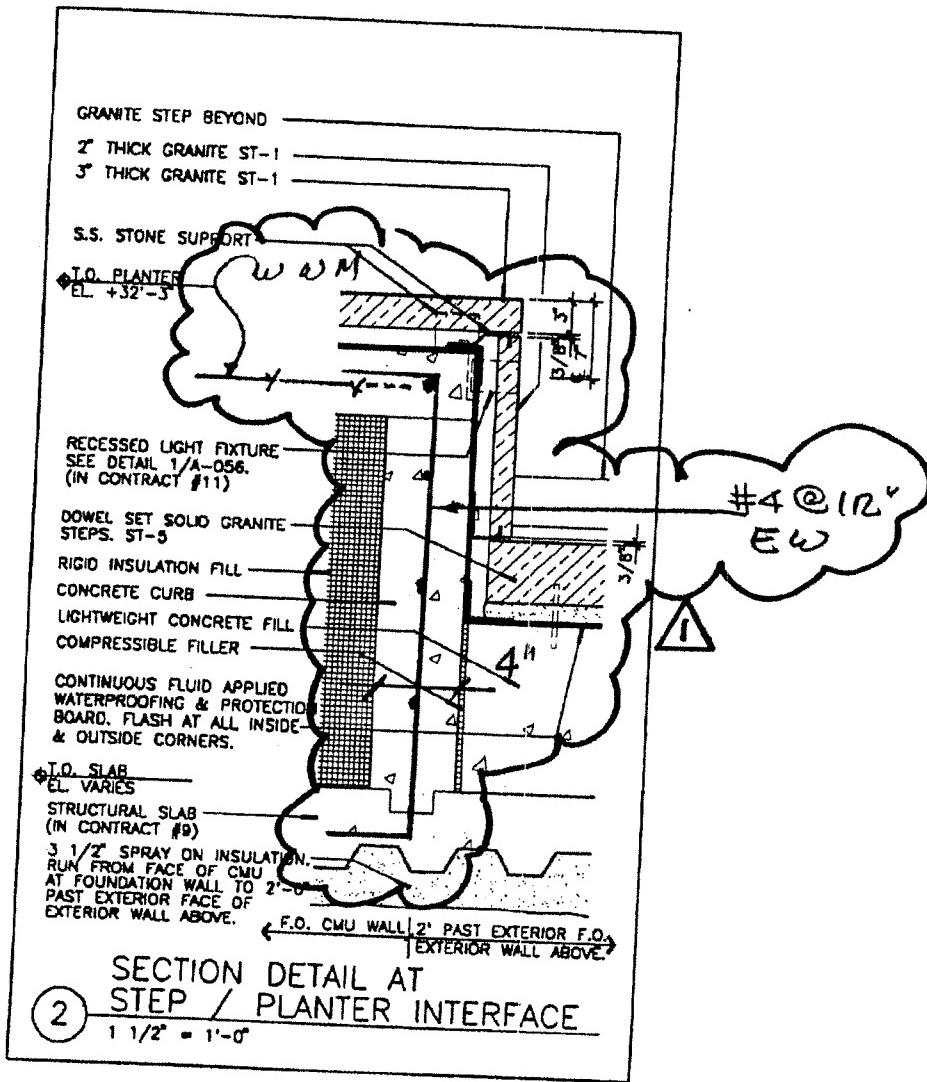

Baruch Academic Complex - Site B

55 LEXINGTON AVENUE

NEW YORK, NY 10010

OWNER

EDUCATIONAL AUTHORITY OF THE STATE OF NEW YORK, DA# 6500 1802 2178
1 PENNSYLVANIA PLAZA

NEW YORK, NY 10119

ARCHITECT

KPF ASSOCIATES
11 WEST 57TH STREET
NEW YORK, NY 10019

REF. DETAIL/SHEET NO.

21A-054

SKETCH NO.

SCALE

3/4" = 1'-0"

1294


NO.

REVISION

DATE

ADDENDUM #2 (CONTRACT #16)

6/5/98

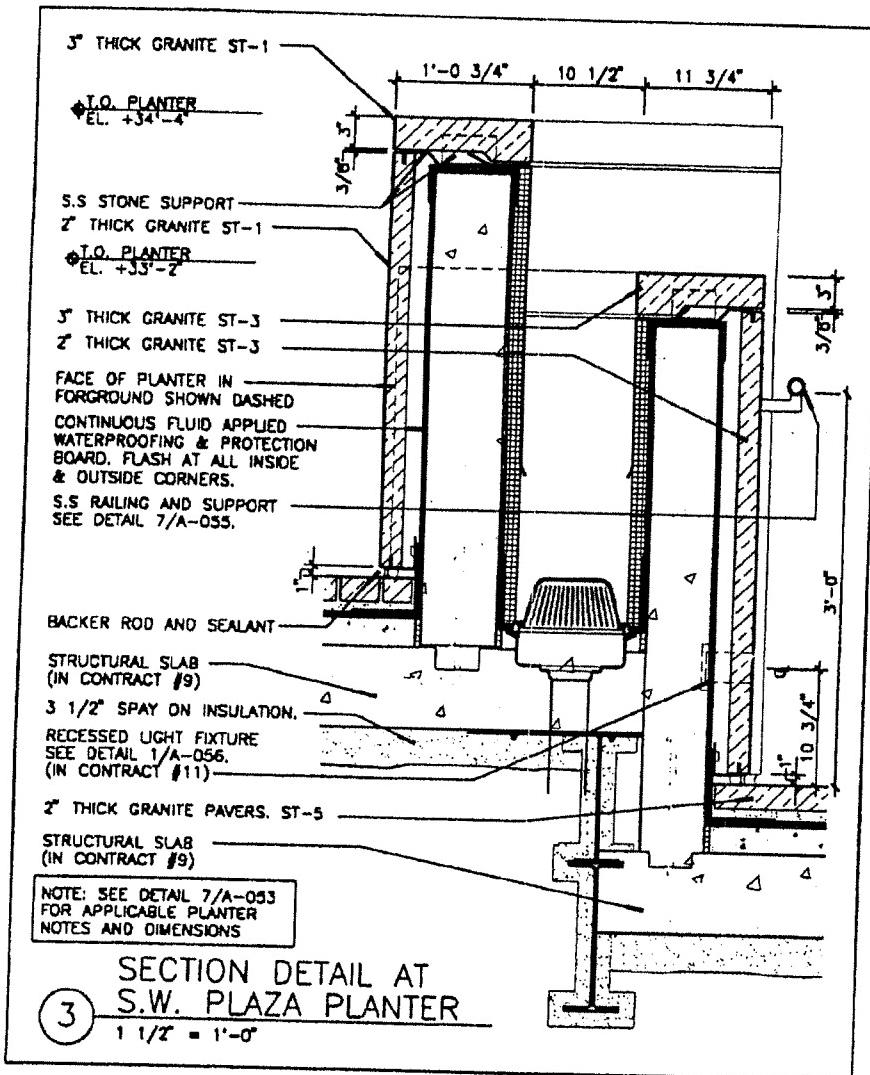

See Section 7/A-054

Baruch Academic Complex - Site B

55 Lexington Avenue

New York, NY 10010

OWNER
TORY AUTHORITY OF THE STATE OF NEW YORK, DA# 6500 1802 2178
1 PENNSYLVANIA PLAZA
NEW YORK, NY 10119

ARCHITECT
KPF ASSOCIATES
11 WEST 57TH STREET
NEW YORK, NY 10019

REF. DETAIL/SHEET NO.
3/A-054

SKETCH NO.

SCALE
3/4" = 1'-0"

1297


NO.

REVISION

DATE

ADDENDUM #2 (CONTRACT #16)

6/5/98

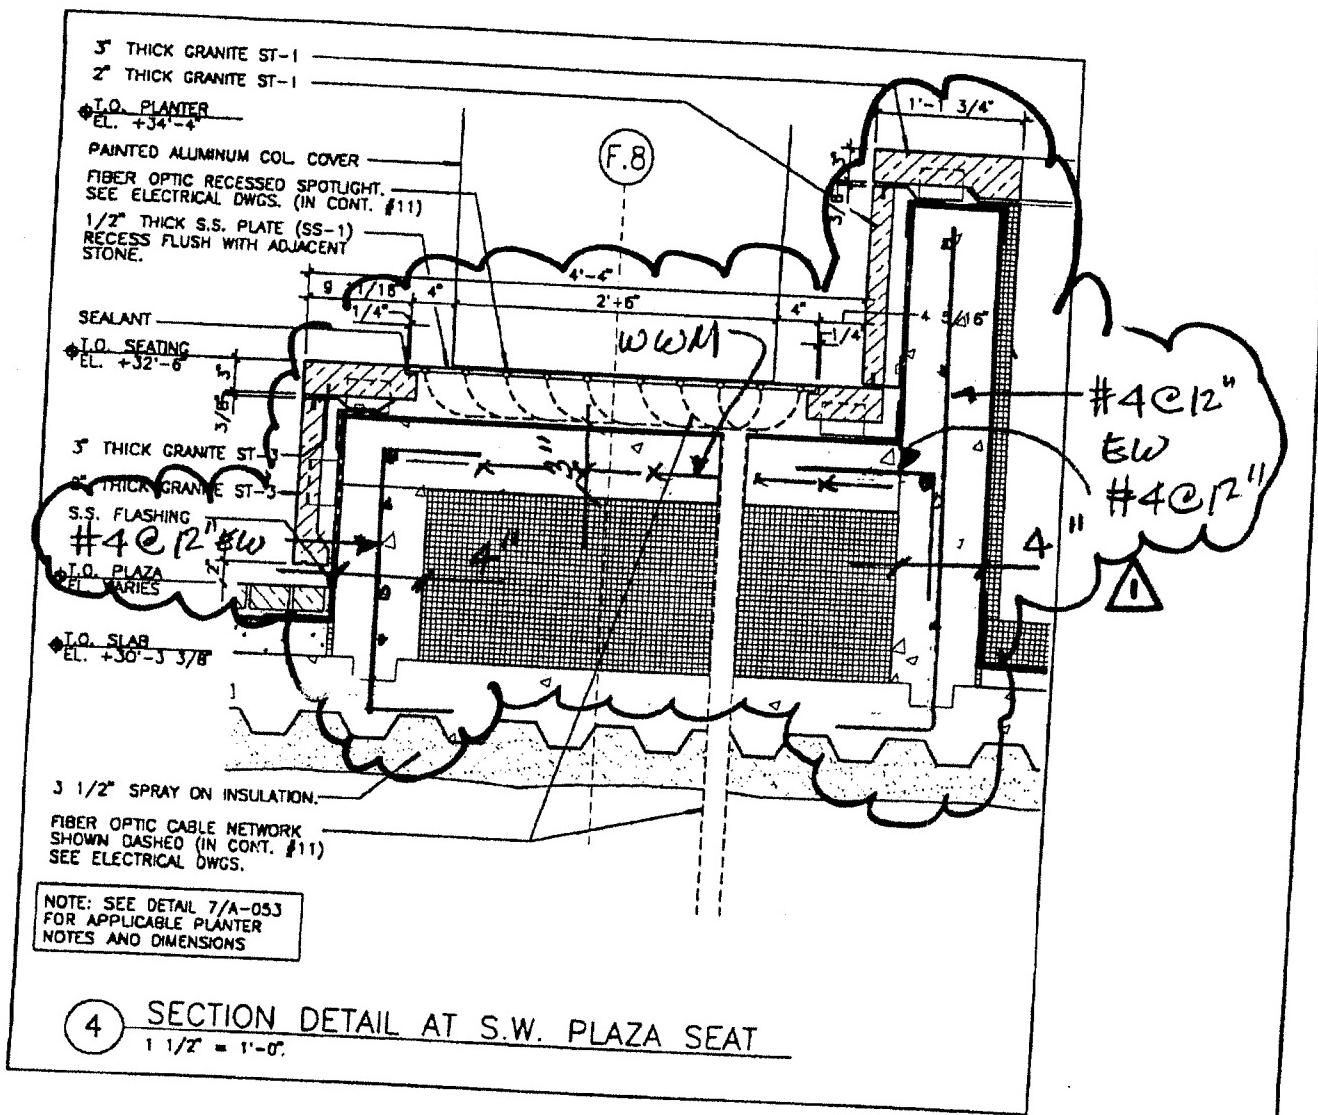

Baruch Academic Complex - Site B

55 LEXINGTON AVENUE

NEW YORK, NY 10010

OWNER

EDUCATIONAL AUTHORITY OF THE STATE OF NEW YORK, DA# 6500 1802 2178
1 PENNSYLVANIA PLAZA

NEW YORK, NY 10119

ARCHITECT
KPF ASSOCIATES
11 WEST 57TH STREET
NEW YORK, NY 10019

REF. DETAIL/SHEET NO.

4/A-054

SKETCH NO.

SCALE

3 1/4" = 1'-0"

1298


NO.

REVISION

DATE

ADDENDUM #2 (CONTRACT #16)

6/5/98

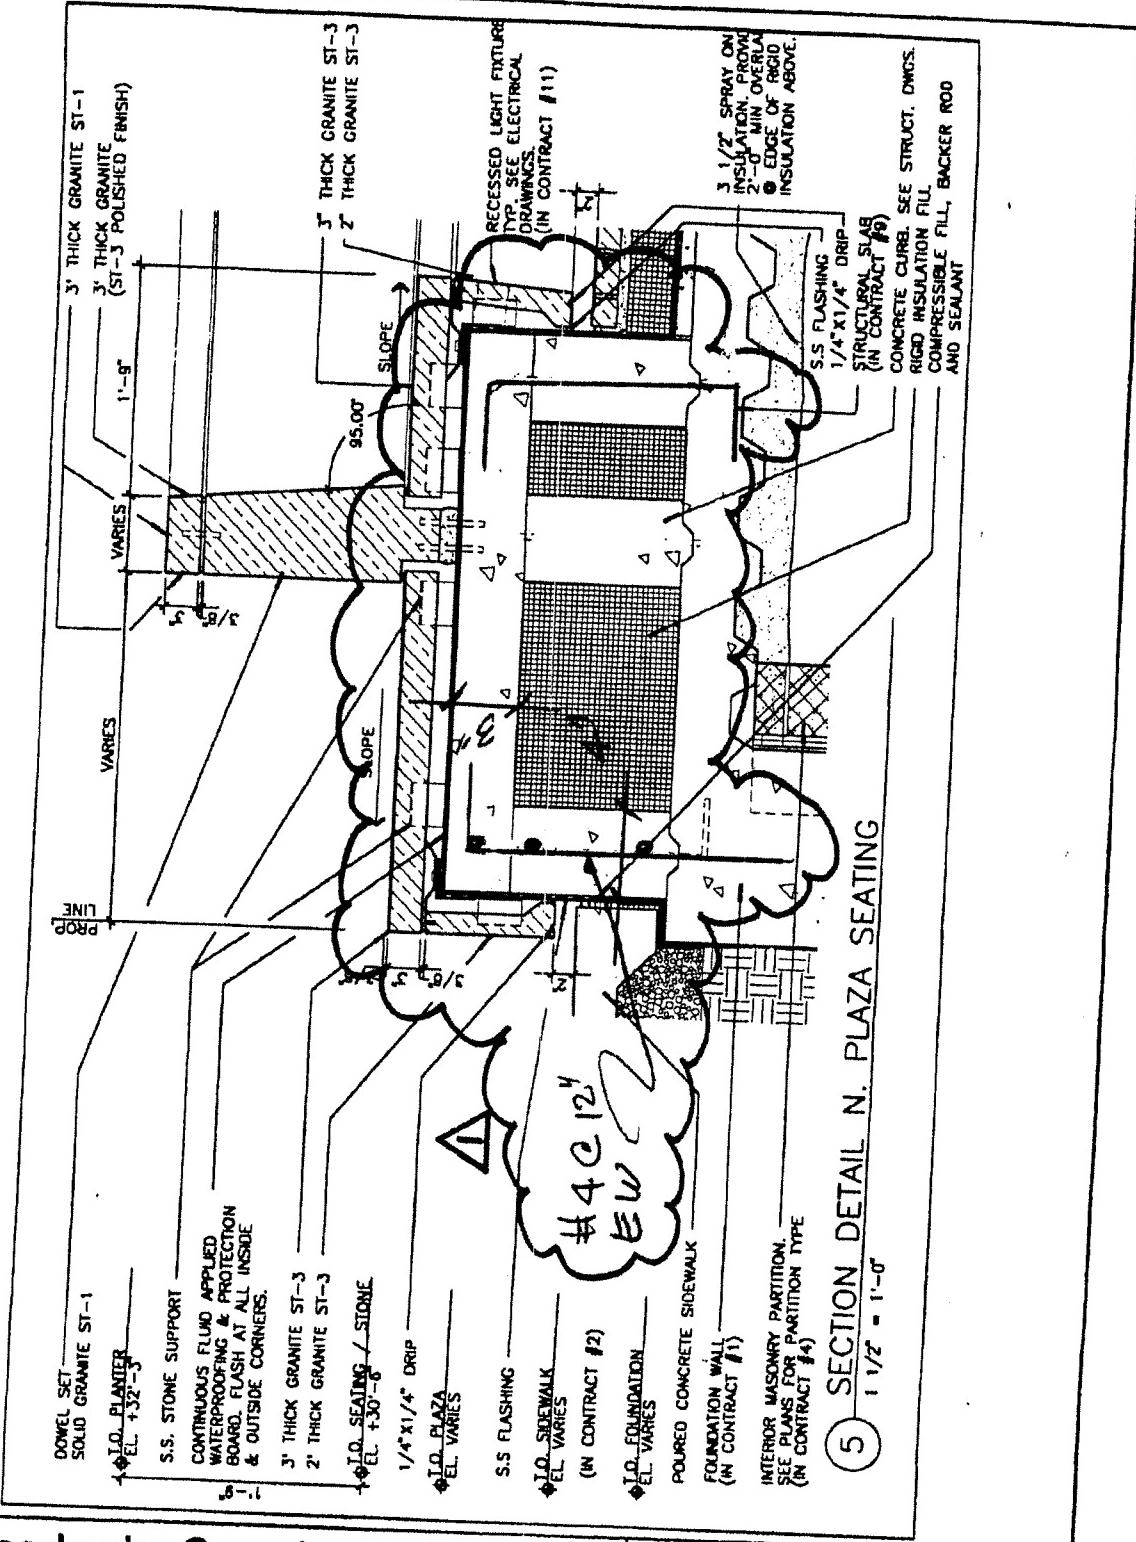

Baruch Academic Complex - Site B

55 LEXINGTON AVENUE

NEW YORK, NY 10010

OWNER

PROPERTY AUTHORITY OF THE STATE OF NEW YORK, DA# 6500 18C2 2178
1 PENNSYLVANIA PLAZA NEW YORK, NY 10119

ARCHITECT
KPF ASSOCIATES
11 WEST 57TH STREET
NEW YORK, NY 10019

REF. DETAIL/SHEET NO.

SKETCH NO.


~~STACOST~~
SCALE

$$\text{SCALE} \rightarrow f = 1 - \sigma^n$$

129

REVISION

DATE

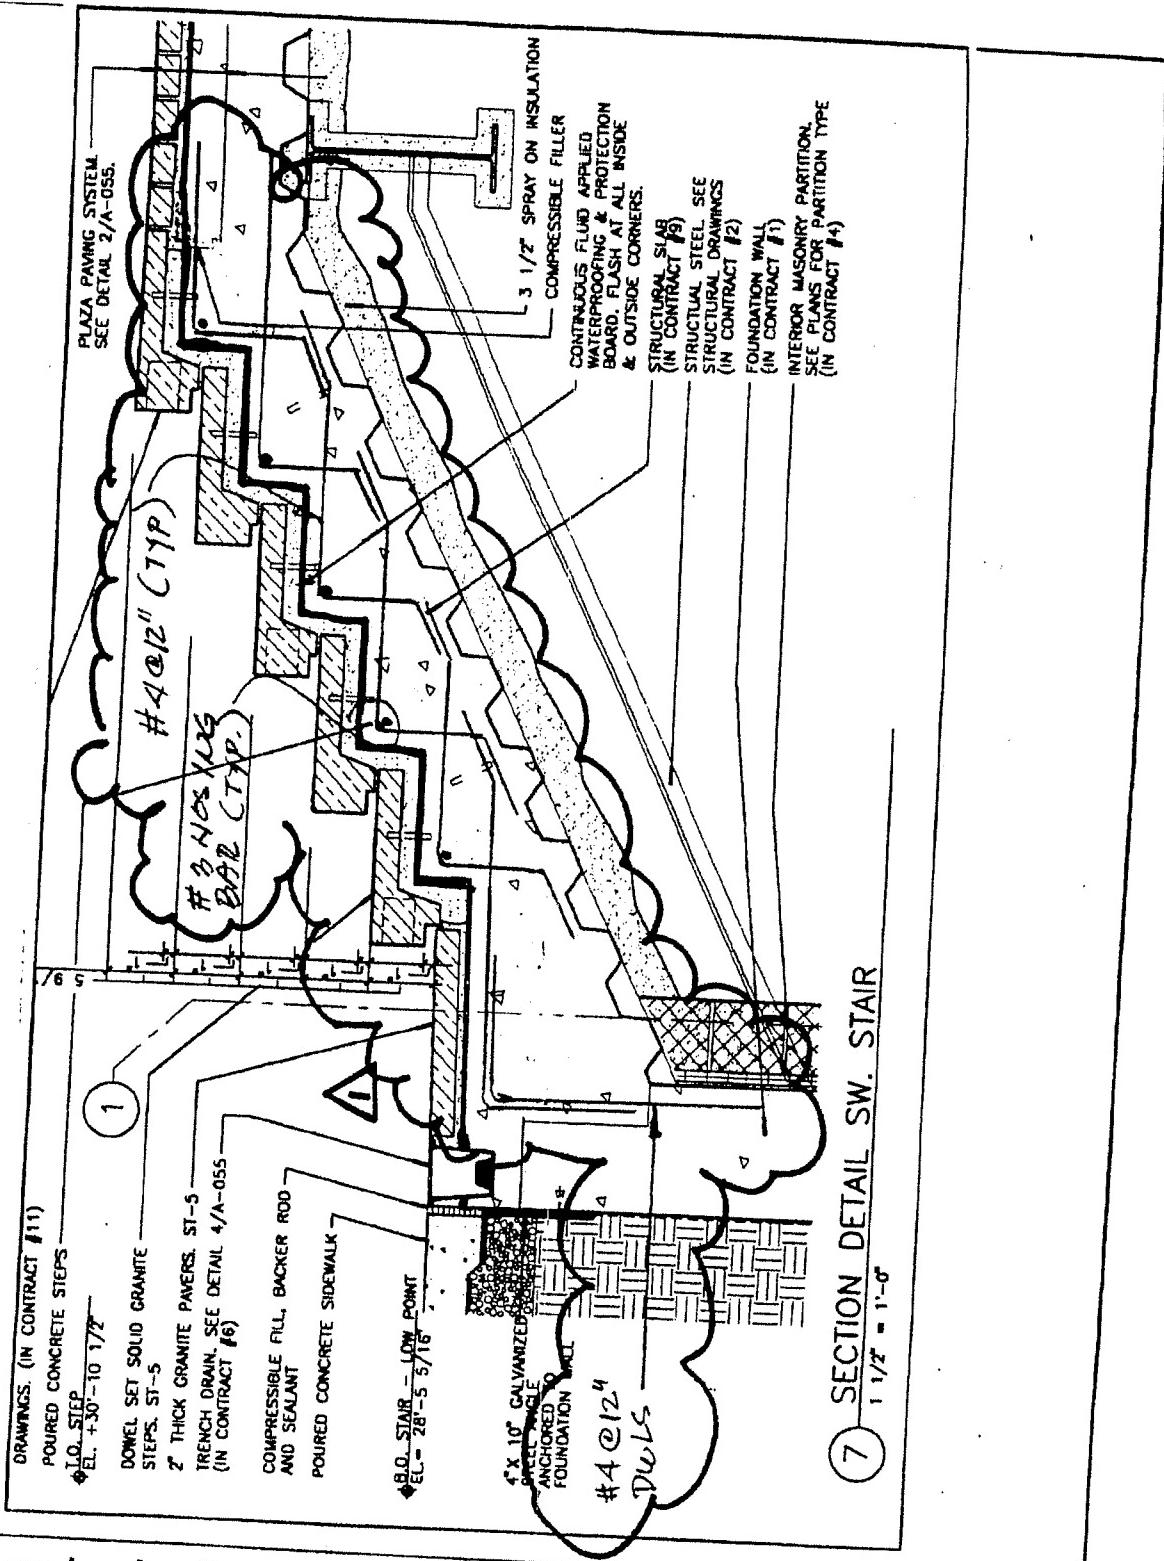

Baruch Academic Complex - Site B

55 LEXINGTON AVENUE

NEW YORK, NY 10010

PROPERTY AUTHORITY OF THE STATE OWNER

1 PENNSYLVANIA PLAZA NEW YORK, NY 10119

REVISION
ADDENDUM #2 (CONTRACT #16)

ARCHITECT
KPF ASSOCIATES
11 WEST 57TH STREET
NEW YORK, NY 10019

REF. DETAL/SHEET NO
7/A-054

SKETCH NO.

SCALE
3/4" = 1'-0"


1300

REVISION

DATE

ADDENDUM #2 (CONTRACT #16)

6/5/98

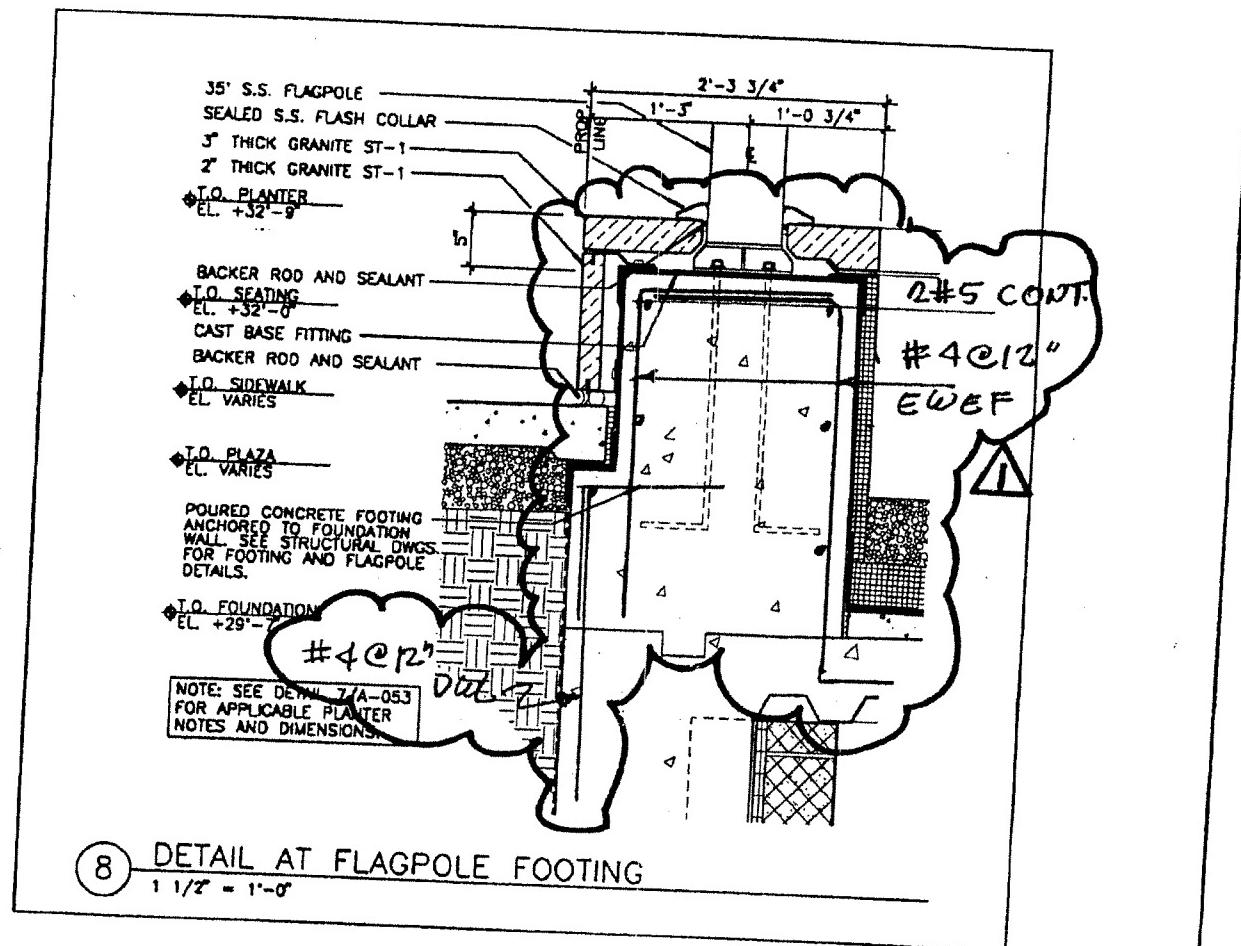

Baruch Academic Complex - Site B

55 LEXINGTON AVENUE

NEW YORK, NY 10010

ARCHITECT

KPF ASSOCIATES
11 WEST 57TH STREET
NEW YORK, NY 10019OWNER
CITY AUTHORITY OF THE STATE OF NEW YORK, DA# 6500 1802 2178
1 PENNSYLVANIA PLAZA
NEW YORK, NY 10119

REF. DETAIL/SHEET NO.

8/A-055

SKETCH NO.

1301

NO.


REVISION

DATE

ADDENDUM #2 (CONTRACT #16)

6/5/98

SCALE
3(4)=1'-0"

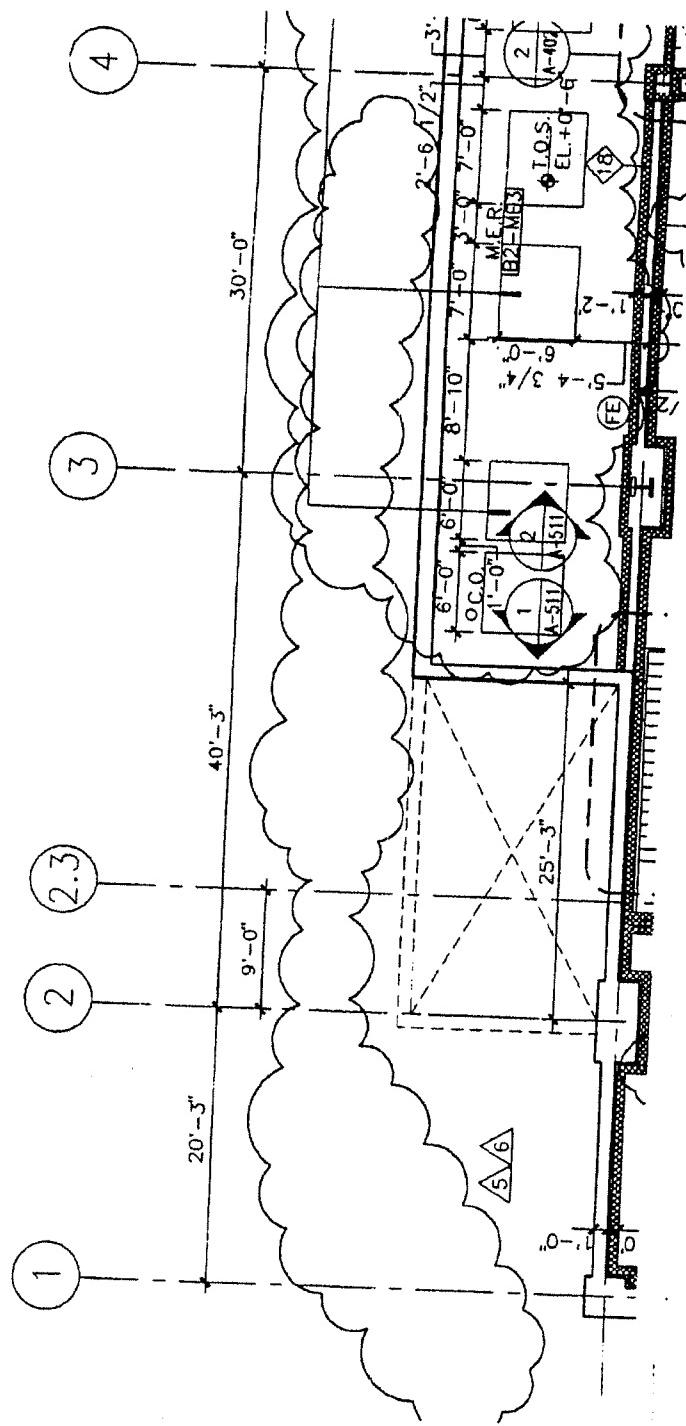

Baruch Academic Complex - Site B

55 LEXINGTON AVENUE NEW YORK, NY 10010

ARCHITECT
KPF ASSOCIATES
11 WEST 57TH STREET
NEW YORK, NY 10019

OWNER
DORMITORY AUTHORITY OF THE STATE OF NEW YORK, DA# 6500 1802 2178
1 PENNSYLVANIA PLAZA NEW YORK, NY 10119

REF. DETAIL/SHEET NO.

VA-102

SKETCH NO.

SCALE

NTS

NO.


REVISION

DATE

6

ADDENDUM #2 (CONTRACT #18)

6/5/98

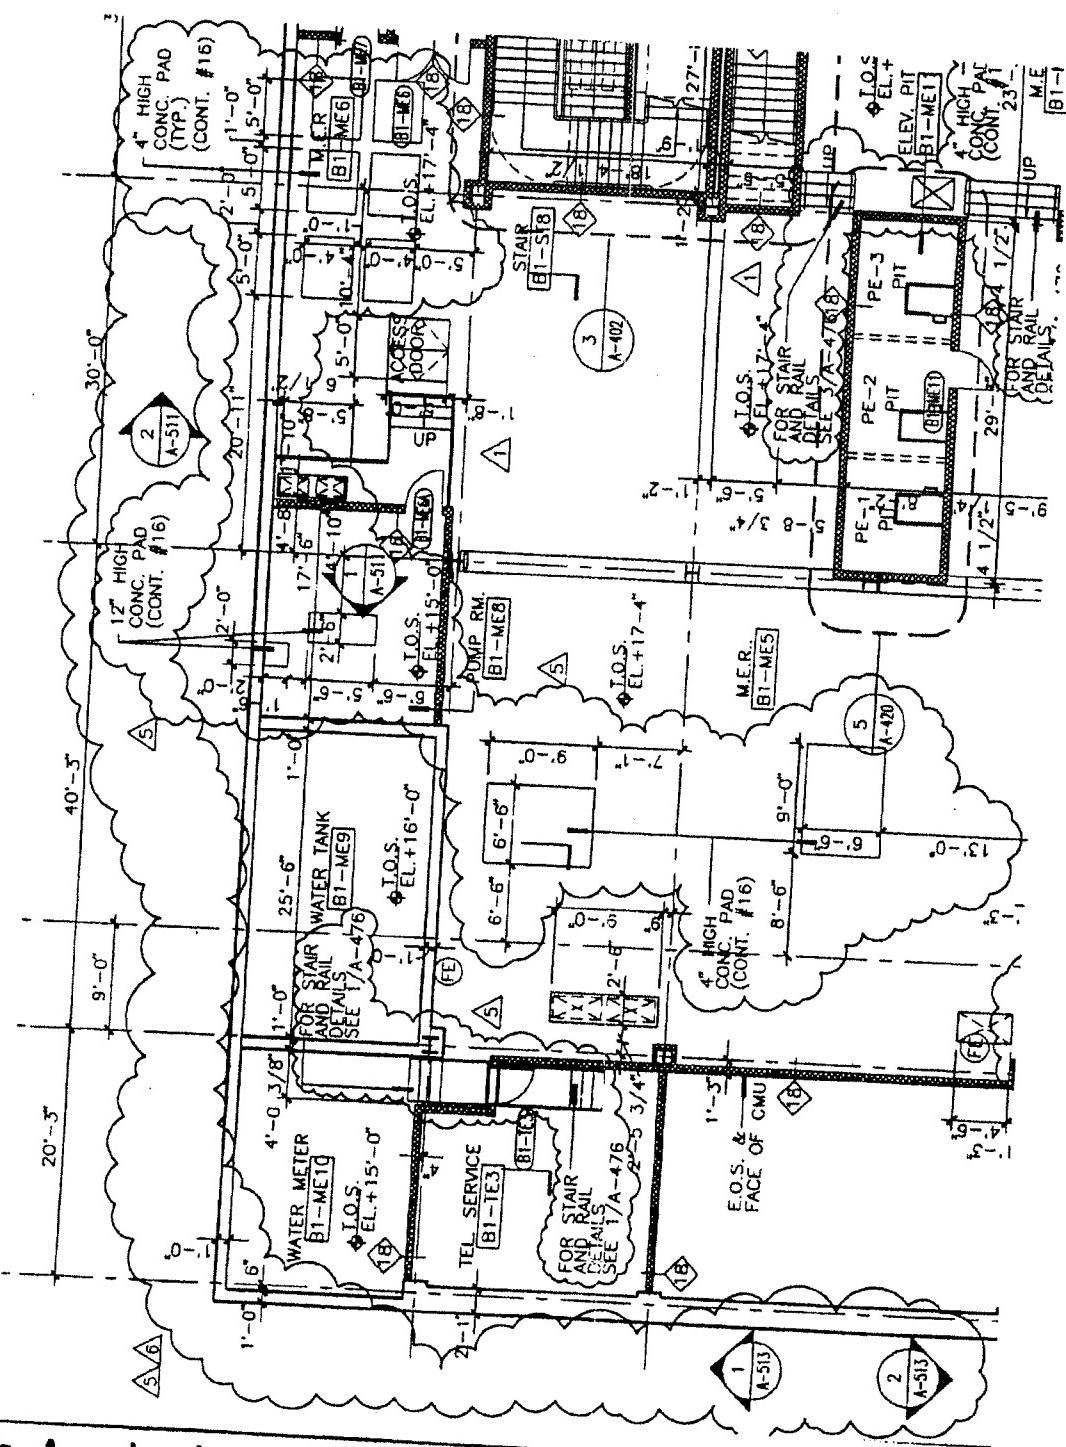

Baruch Academic Complex - Site B

55 LEXINGTON AVENUE

NEW YORK, NY 10010

OWNER

DORMITORY AUTHORITY OF THE STATE OF NEW YORK, DA# 6500 1802 2178
1 PENNSYLVANIA PLAZA
NEW YORK, NY 10119

ARCHITECT
KPF ASSOCIATES
11 WEST 57TH STREET
NEW YORK, NY 10019

REF. DETAIL/SHEET NO.

1/A-103

SKETCH NO.

1303

SCALE


N TS

REVISION

DATE

6/5/98

ADDENDUM #2 (CONTRACT #16)

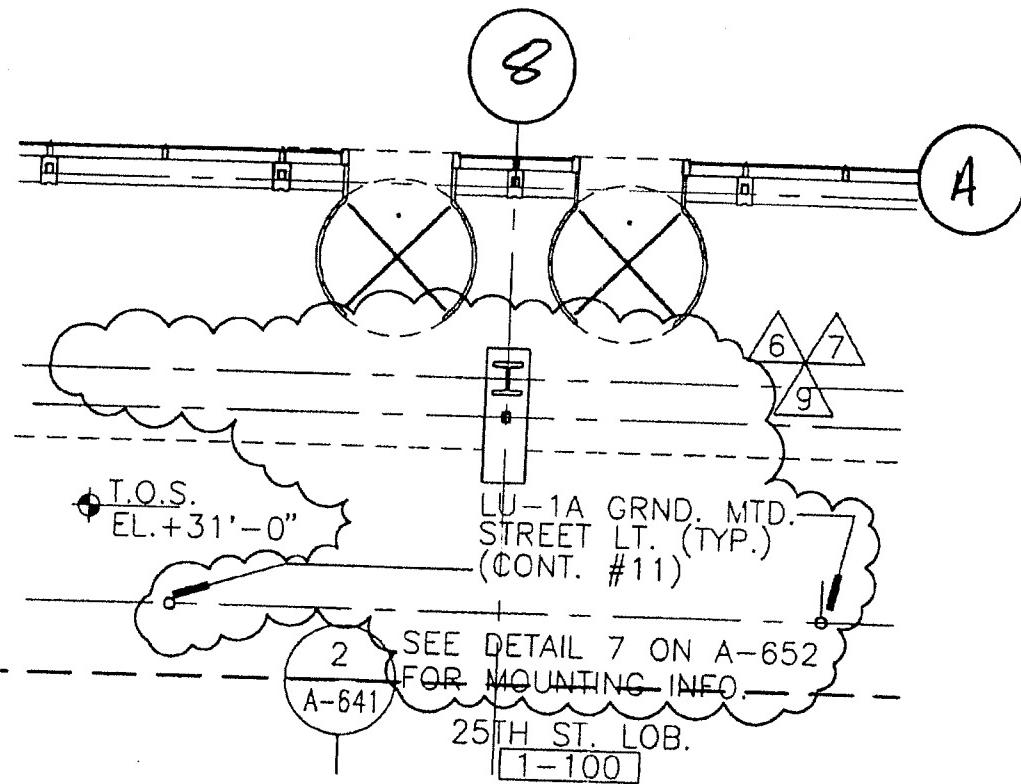

Baruch Academic Complex - Site B

55 Lexington Avenue

New York, NY 10010

OWNER

EDUCATIONAL AUTHORITY OF THE STATE OF NEW YORK, DA# 6500 1802 2178
1 PENNSYLVANIA PLAZA

New York, NY 10119

ARCHITECT
KPF ASSOCIATES
11 WEST 57TH STREET
NEW YORK, NY 10019

REF. DETAIL/SHEET NO.

A-104

SKETCH NO.

1304

NO.


REVISION

DATE

SCALE 1/8" = 1'-0"

ADDENDUM #2 (CONTRACT #16)

6/5/98

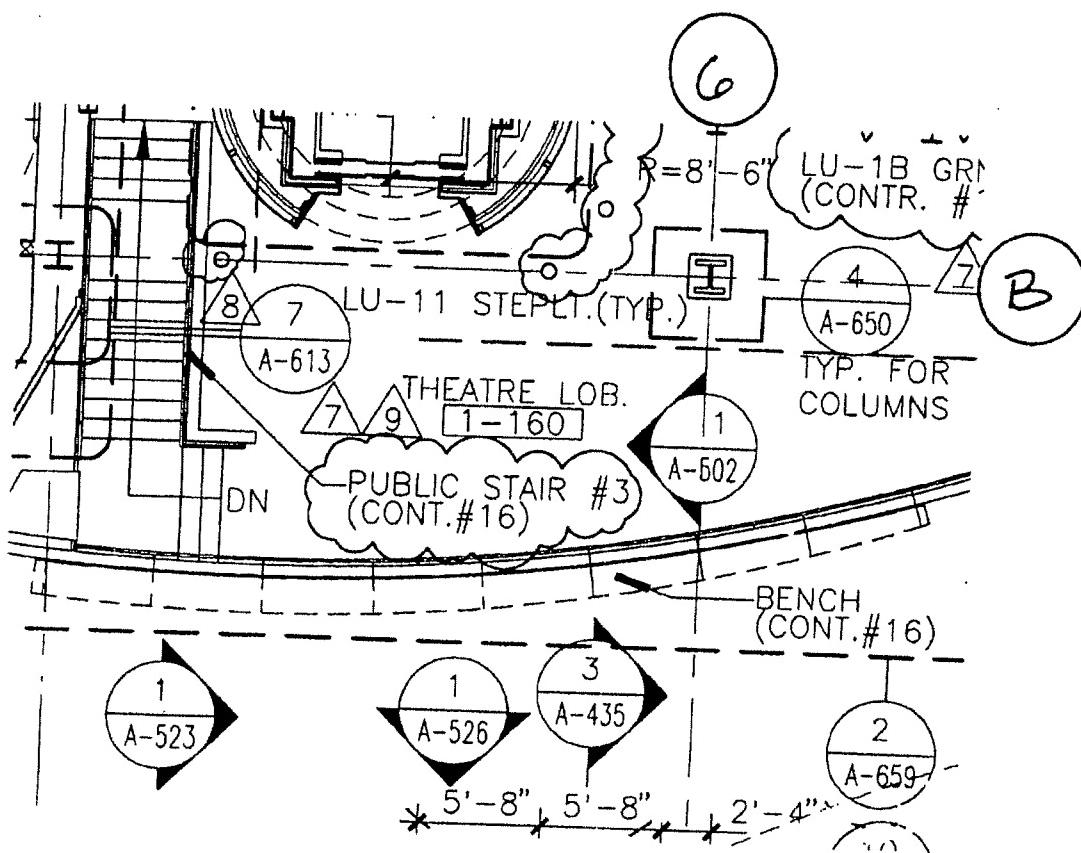

Baruch Academic Complex - Site B

55 Lexington Avenue

New York, NY 10010

ARCHITECT

KPF ASSOCIATES
11 WEST 57TH STREET
NEW YORK, NY 10019CONSTITUTORY AUTHORITY OF THE STATE OF NEW YORK, DA# 6500 1802 2178
1 PENNSYLVANIA PLAZA
NEW YORK, NY 10119

10.

REVISION

DATE

ADDENDUM #2 (CONTRACT #16)

6/5/98


REF. DETAIL/SHEET NO.

A-104

SKETCH NO.

SCALE

18'-11-0"

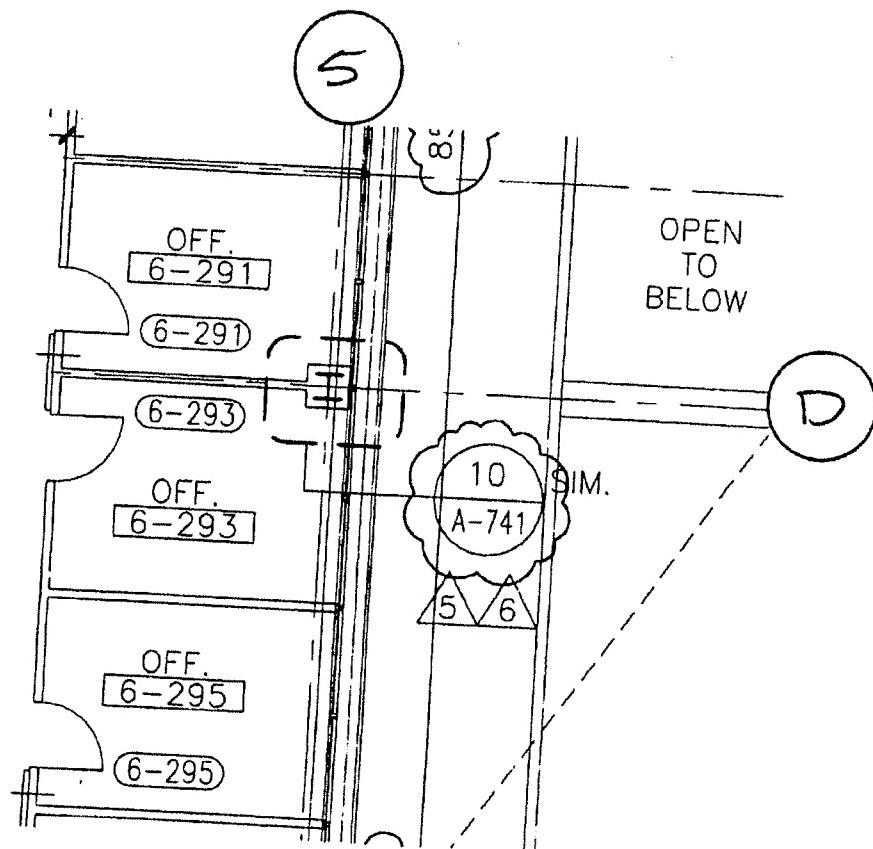

Baruch Academic Complex - Site B

55 LEXINGTON AVENUE

NEW YORK, NY 10010

OWNER

DEPARTMENT OF STATE OF NEW YORK, DA# 6500 1802 2178
1 PENNSYLVANIA PLAZA NEW YORK, NY 10119

ARCHITECT
KPF ASSOCIATES

11 WEST 57TH STREET
NEW YORK, NY 10019

REF. DETAIL/SHEET NO.

A-110

SKETCH NO.

SCALE 1/8" : 1'-0"

SK-1301


NO.

REVISION

DATE

ADDENDUM #2 (CONTRACT #16)

6/5/98

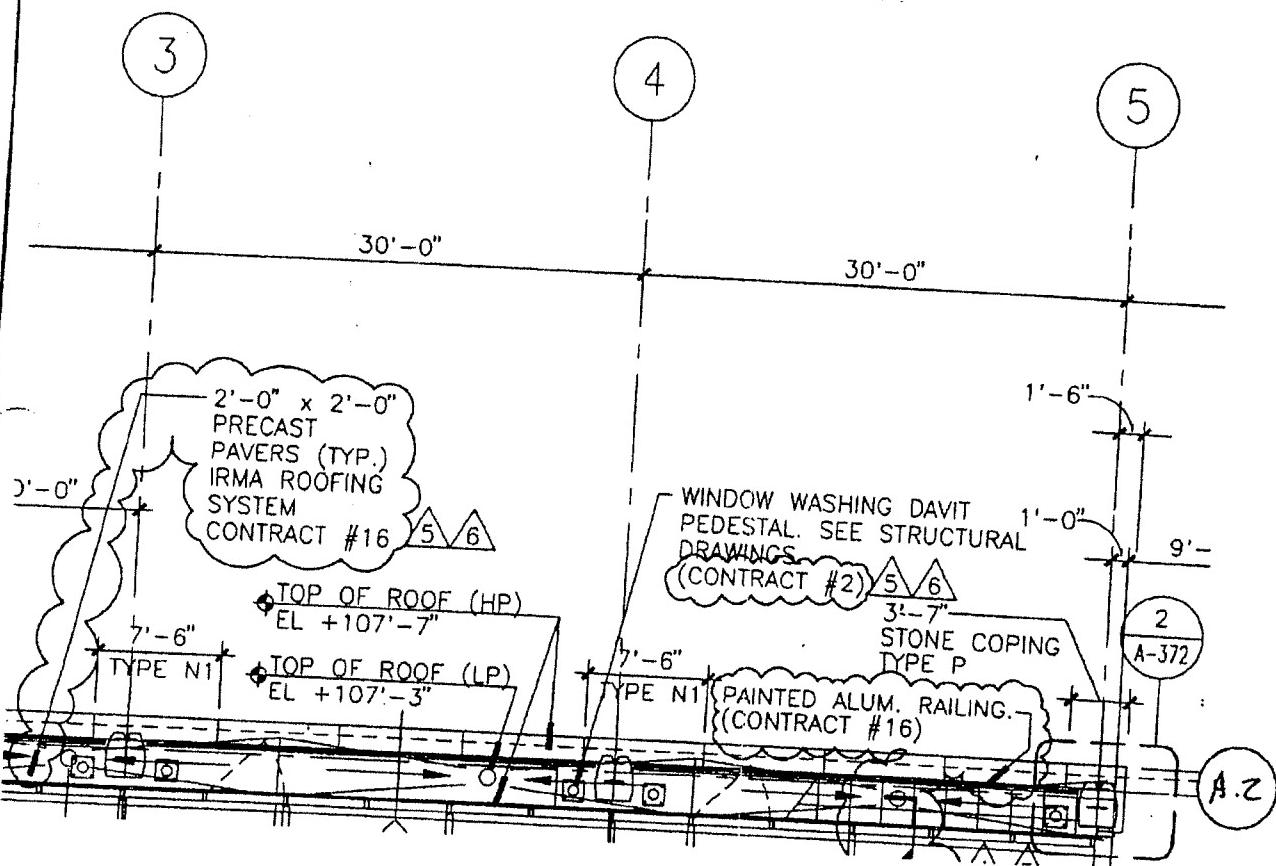

Baruch Academic Complex - Site B

55 Lexington Avenue

NEW YORK, NY 10010

ARCHITECT
KPF ASSOCIATES
11 WEST 57TH STREET
NEW YORK, NY 10019

OWNER
MUNICIPAL AUTHORITY OF THE STATE OF NEW YORK, DA# 6500 1802 2178
1 PENNSYLVANIA PLAZA
NEW YORK, NY 10119

REF. DETAIL/SHEET NO.

A-110

SKETCH NO.

SK-1308

NO.


REVISION

DATE

SCALE

6 ADDENDUM #2 (CONTRACT #16)

6/5/98

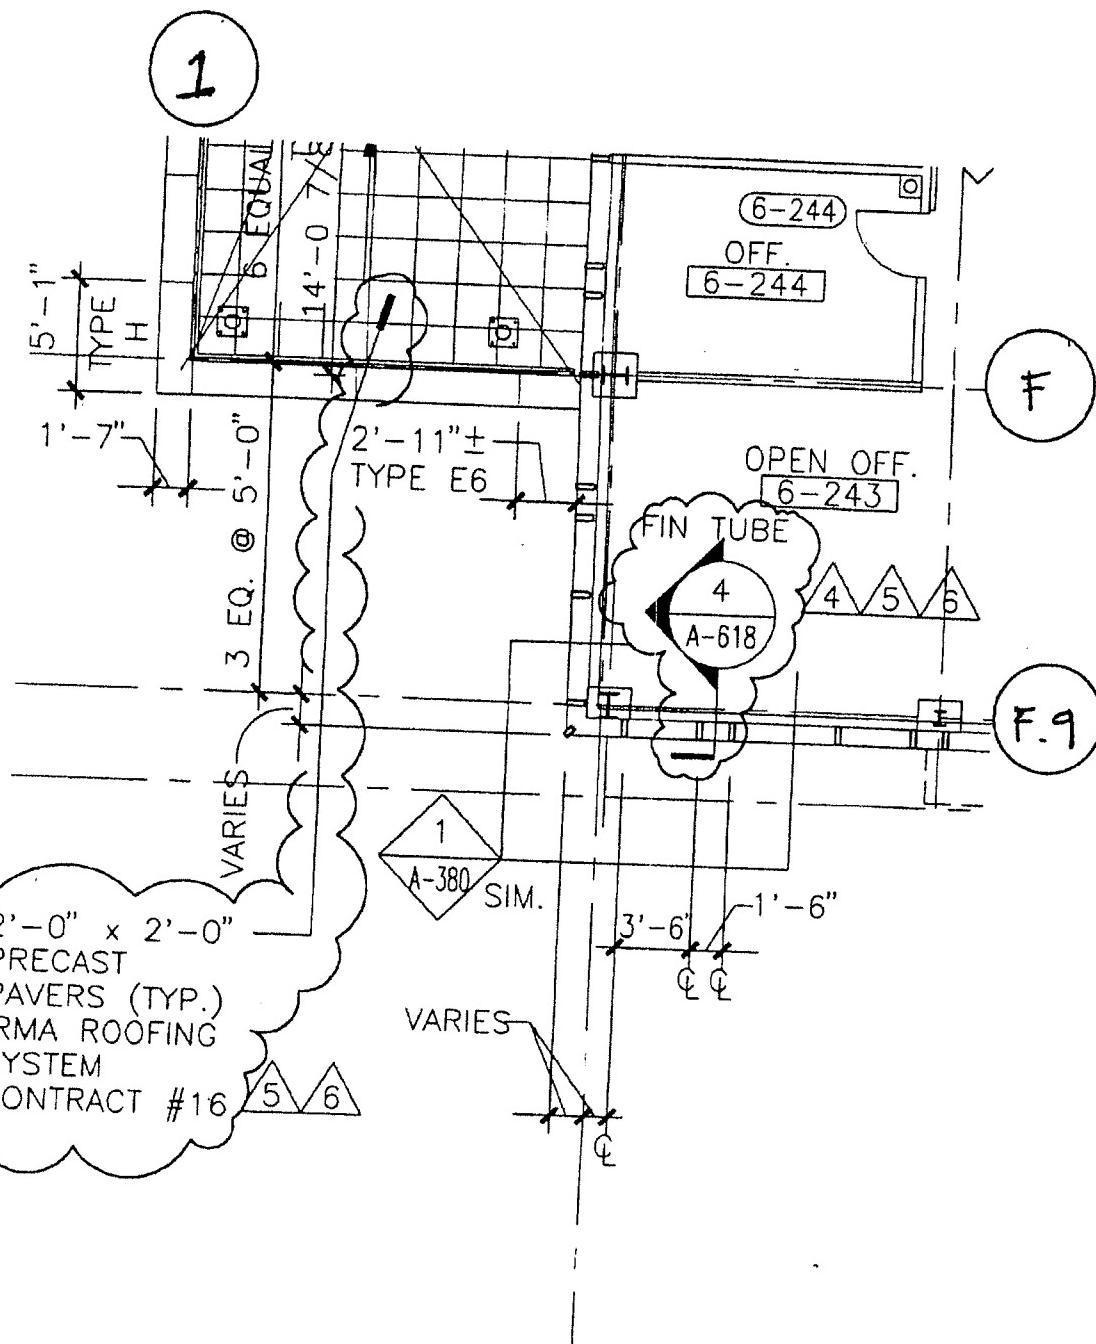

Baruch Academic Complex - Site B

55 LEXINGTON AVENUE

NEW YORK, NY 10010

ARCHITECT

KPF ASSOCIATES
11 WEST 57TH STREET
NEW YORK, NY 10019OWNER
DORMITORY AUTHORITY OF THE STATE OF NEW YORK, DA# 6500 1802 2178
1 PENNSYLVANIA PLAZA NEW YORK, NY 10119

REF. DETAIL/SHEET NO.

A-110

SKETCH NO.

SCALE

1/8" = 1'-0"

Sk. B09

NO.


REVISION

DATE

6

ADDENDUM #2 (CONTRACT #16)

6/5/98

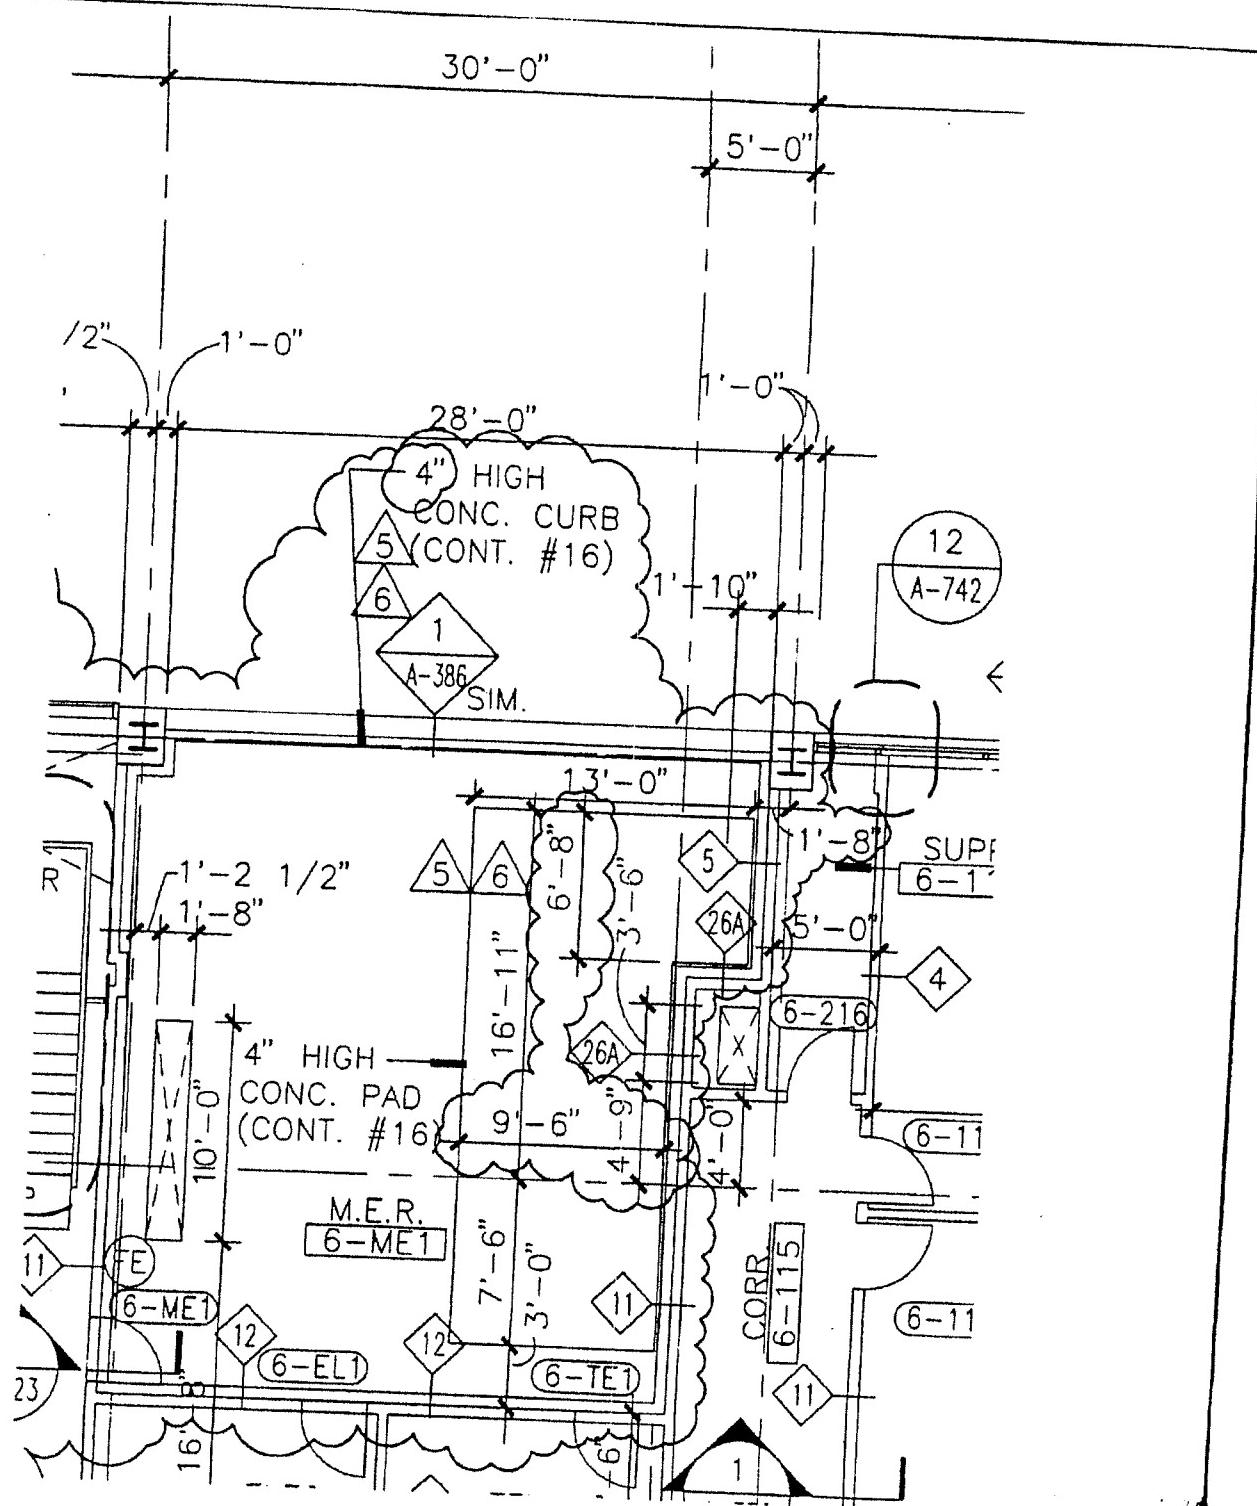


Baruch Academic Complex - Site B

55 LEXINGTON AVENUE NEW YORK, NY 10010

ARCHITECT
KPF ASSOCIATES
11 WEST 57TH STREET
NEW YORK, NY 10019

OWNER		11 WEST 57TH STREET NEW YORK, NY 10019	
DORMITORY AUTHORITY OF THE STATE OF NEW YORK, DA# 6500 1802 2178 1 PENNSYLVANIA PLAZA		REF. DETAL/SHEET NO. A-110	
NEW YORK, NY 10119		SKETCH NO. SK-1310	
NO.	REVISION	DATE	SCALE $1/8 = 1'-0"$
6	ADDENDUM #2 (CONTRACT #16)	6/5/98	

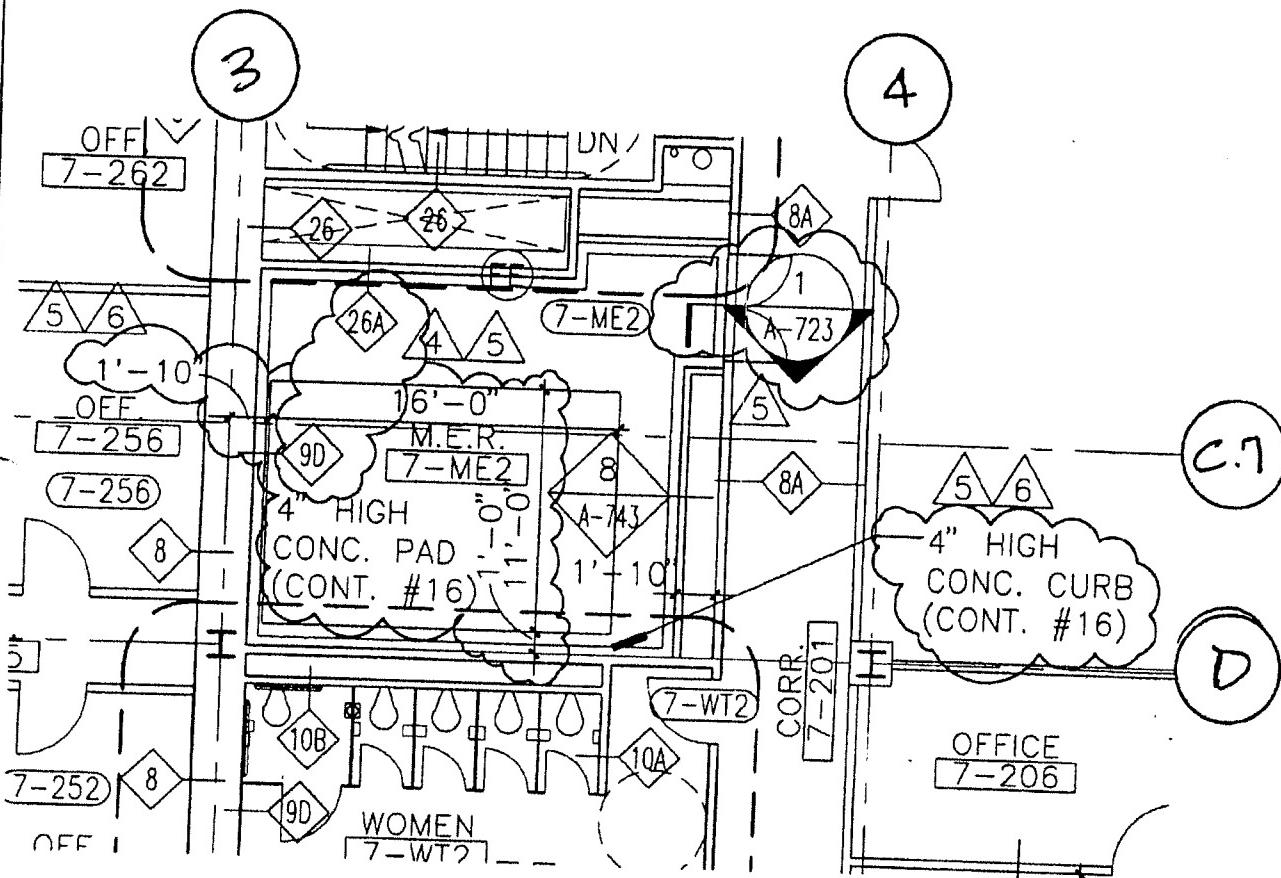

Baruch Academic Complex - Site B

55 LEXINGTON AVENUE NEW YORK, NY 10010

OWNER


TERRITORY AUTHORITY OF THE STATE OF NEW YORK, DA# 6500 1802 2178
1 PENNSYLVANIA PLAZA NEW YORK, NY 10119

ARCHITECT
KPF ASSOCIATES
11 WEST 57TH STREET
NEW YORK, NY 10019

REF. DETAIL/SHEET NO.
A-111

SKETCH NO.

NO.	REVISION	DATE	SCALE	
6	ADDENDUM #2 (CONTRACT #16)	6/5/98	1/8" = 1'-0"	SK-1311

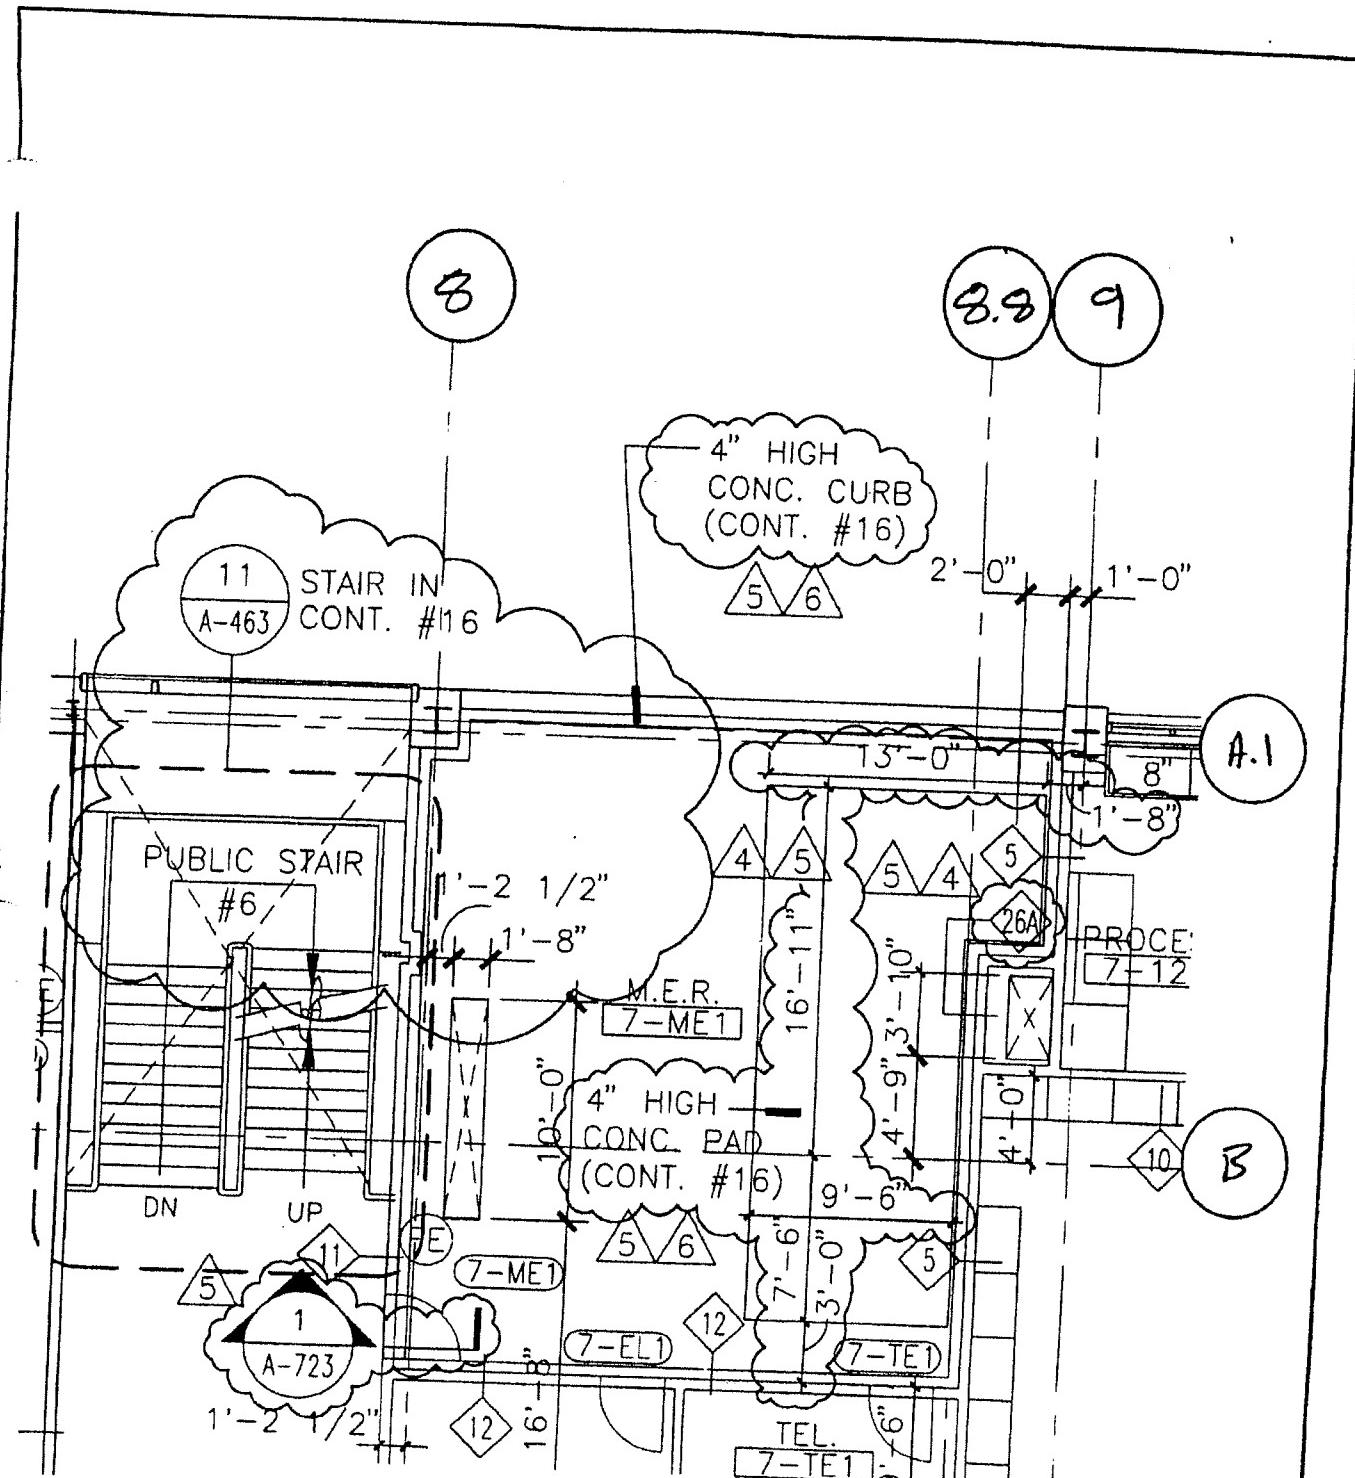

Baruch Academic Complex - Site B

55 Lexington Avenue

New York, NY 10010

OWNER

CORPORATION AUTHORITY OF THE STATE OF NEW YORK, DA# 6500 1802 2178
1 PENNSYLVANIA PLAZA NEW YORK, NY 10119

ARCHITECT

KPF ASSOCIATES
11 WEST 57TH STREET
NEW YORK, NY 10019

REF. DETAIL/SHEET NO.

A-111

SKETCH NO.

SK-1312

NO.

REVISION


DATE

(6)


ADDENDUM #2 (CONTRACT #16)

6/5/98

SCALE 1/8" = 1'-0"

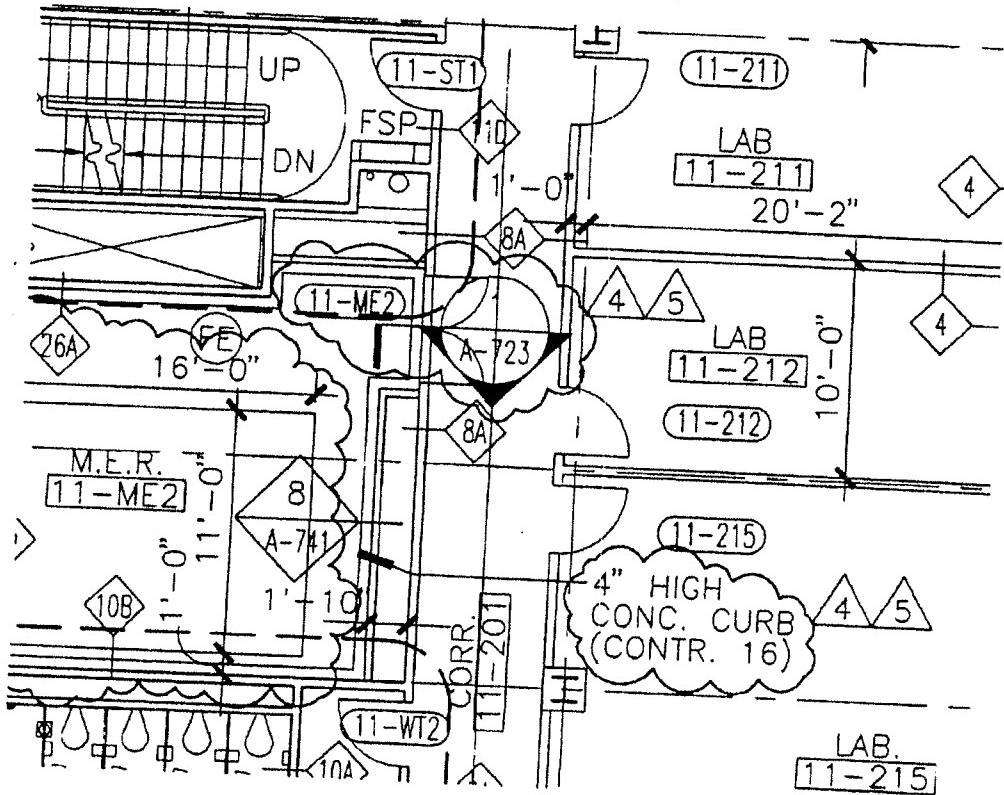

Baruch Academic Complex - Site B		ARCHITECT
55 LEXINGTON AVENUE	NEW YORK, NY 10010	KPF ASSOCIATES
OWNER		11 WEST 57TH STREET
DORMITORY AUTHORITY OF THE STATE OF NEW YORK, DA# 6500 1802 2178 1 PENNSYLVANIA PLAZA		NEW YORK, NY 10019
		REF. DETAIL/SHEET NO.
		A-115
		SKETCH NO.
NO.	REVISION	DATE
5	ADDENDUM #2 (CONTRACT #16)	6/5/98
		SCALE
		SK-1313

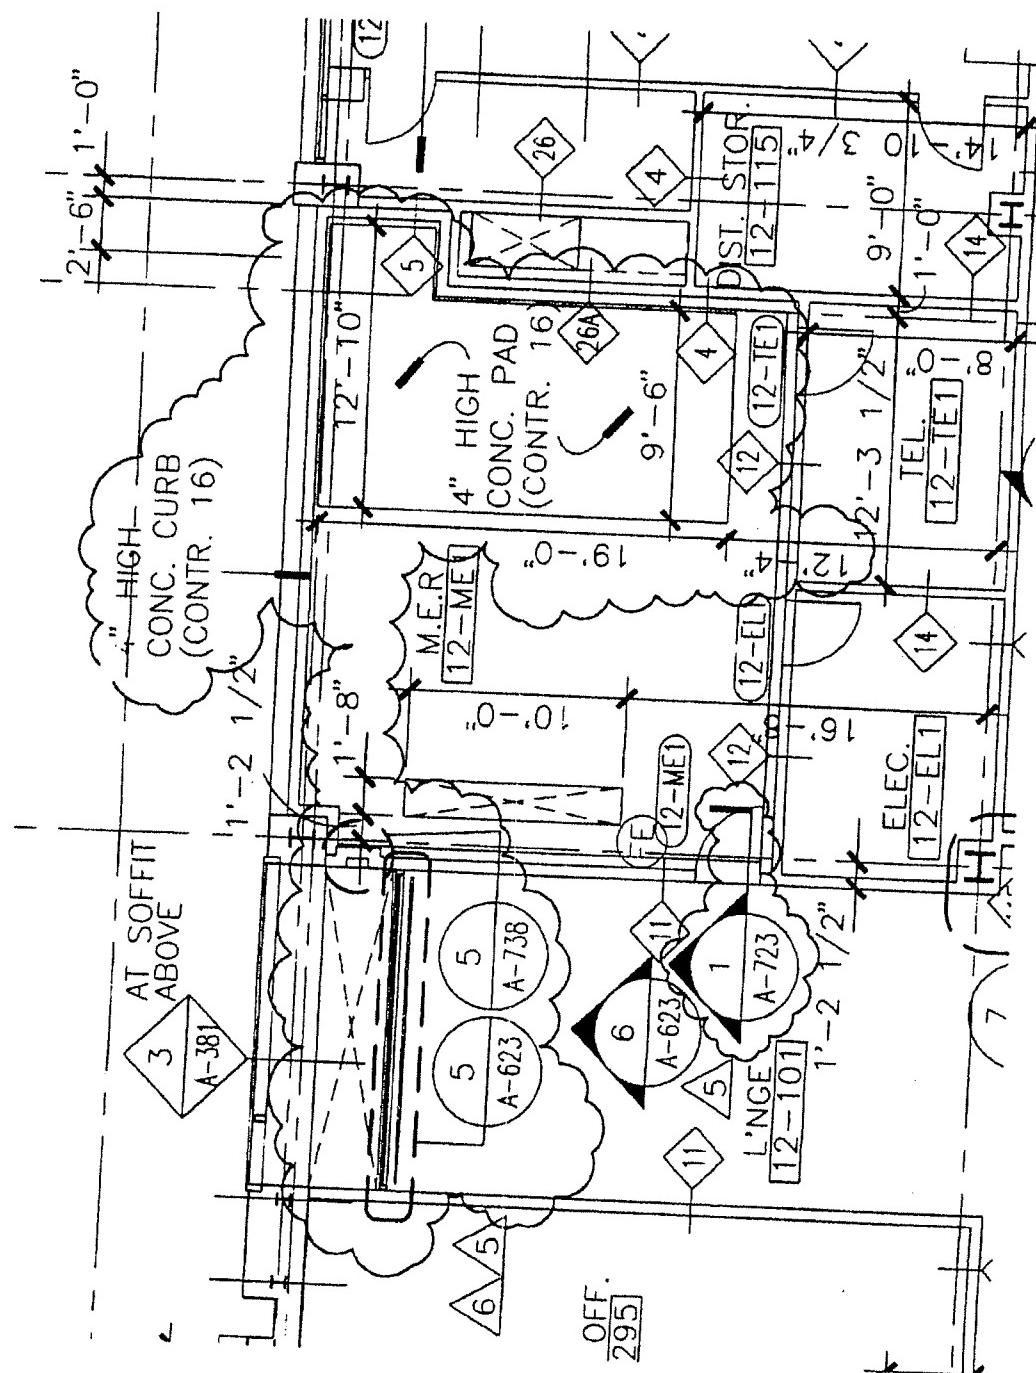

Baruch Academic Complex - Site B
55 LEXINGTON AVENUE
NEW YORK, NY 10010

OWNER
DORMITORY AUTHORITY OF THE STATE OF NEW YORK, DA# 5500 1802 2178
1 PENNSYLVANIA PLAZA
NEW YORK, NY 10119

ARCHITECT
KPF ASSOCIATES
11 WEST 57TH STREET
NEW YORK, NY 10019

REF. DETAIL/SHEET NO.

A-116

SKETCH NO.

NO.


REVISION

DATE

6/5/98

SCALE

SK-1314

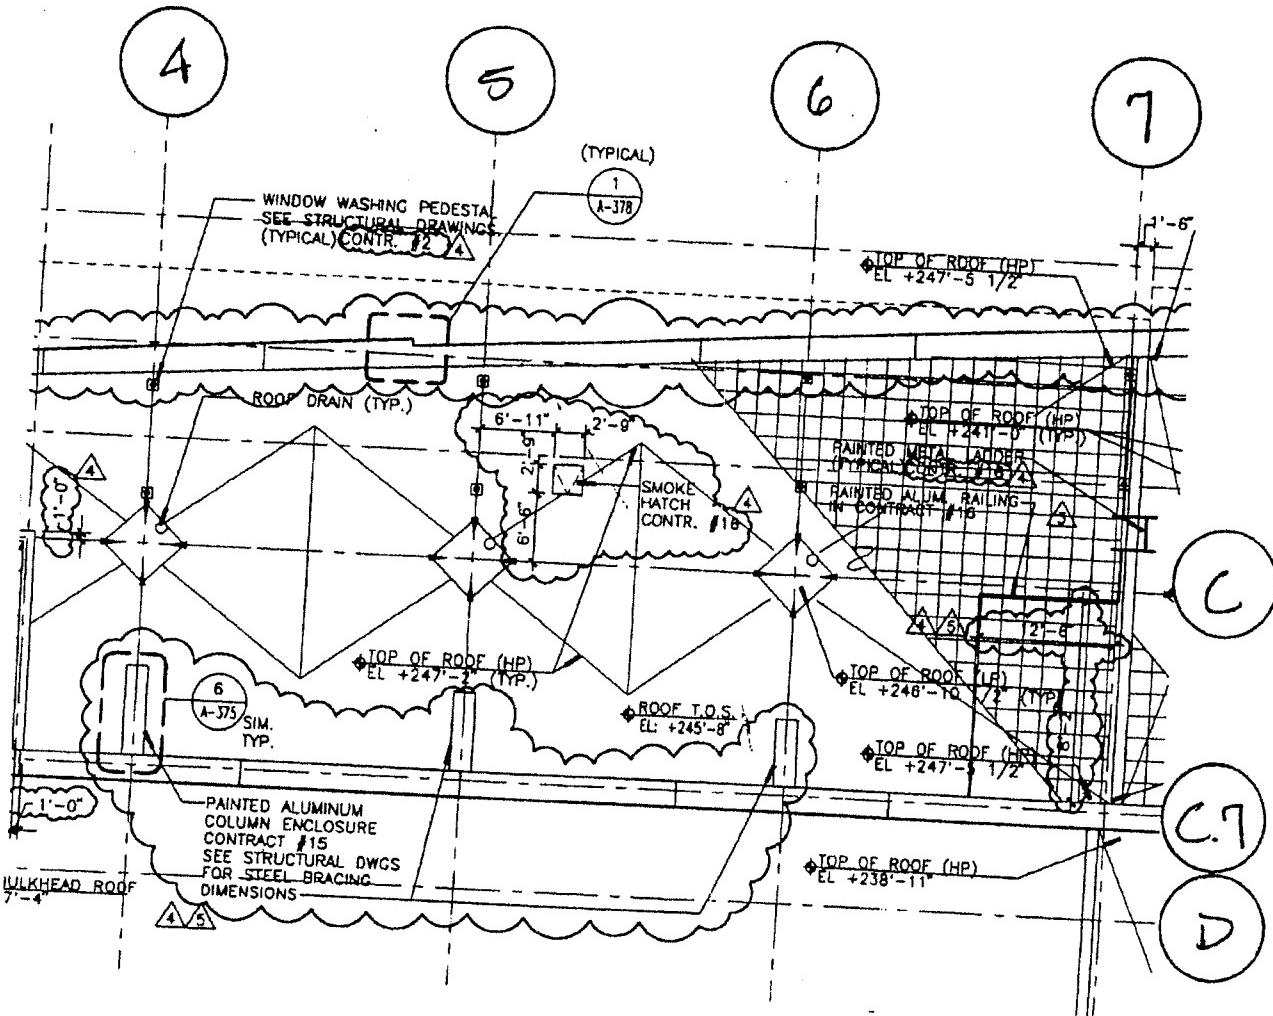

Baruch Academic Complex - Site B

55 Lexington Avenue

New York, NY 10010

OWNER

EDUCATIONAL AUTHORITY OF THE STATE OF NEW YORK, DA# 6500 1802 2178
1 PENNSYLVANIA PLAZA

New York, NY 10119

ARCHITECT
KPF ASSOCIATES
11 WEST 57TH STREET
NEW YORK, NY 10019

REF. DETAIL/SHEET NO.
A-120

SKETCH NO.

NO.

REVISION

DATE

SCALE $1/8'' = 1'-0''$

SK-1315

5

ADDENDUM #2 (CONTRACT #16)


6/5/98

7. ALL FIXTURES ARE LOCATED BY CENTERLINES UNLESS OTHERWISE INDICATED
 8. FIELD CUT C-2 CEILING PANELS TYPE 'C', 'D', AND 'F' AS NEEDED AT ENDS OF CORRIDORS
 9. CUT C-1 TILES SHALL NOT BE LESS THAN 3" WIDE CUT FROM 2' x 4' TILES ALONG PERIMITERS WHERE A CUT 2' x 2' TILE WOULD BE LESS THAN 3" WIDE.
 10. LIGHT FIXTURES (L.U.) ARE IN CONTRACT #11 AND ARE SHOWN ON THESE PLANS FOR COORDINATION WITH CONTRACTS #15 AND #16.
 1. ALL CEILING WORK ON THIS SHEET IN CONTRACT #15 UNLESS OTHERWISE NOTED

THE FOLLOWING NOTES APPLY TO A-121 THRU A-135

1. RECESS GWB POCKETS AT PROJECTION SCREEN
IN CONTRACT #15
 2. PROJECTION SCREENS, MANUAL AND MOTORIZED,
IN CONTRACT #16
 3. RECESS GWB BLIND POCKETS IN CONTRACT #15
 4. ROLL-UP SHADES, MANUAL AND MOTORIZED,
IN CONTRACT #16

Baruch Academic Complex - Site B		ARCHITECT KPF ASSOCIATES 11 WEST 57TH STREET NEW YORK, NY 10019
55 LEXINGTON AVENUE	NEW YORK, NY 10010	
OWNER DORMITORY AUTHORITY OF THE STATE OF NEW YORK, DA# 6500 1802 2178 1 PENNSYLVANIA PLAZA NEW YORK, NY 10119		REF. DETAIL/SHEET NO. A-121
NO.	REVISION	DATE
4	ADDENDUM #2 (CONTRACT #16)	6/5/98
		SCALE
		SK-1316

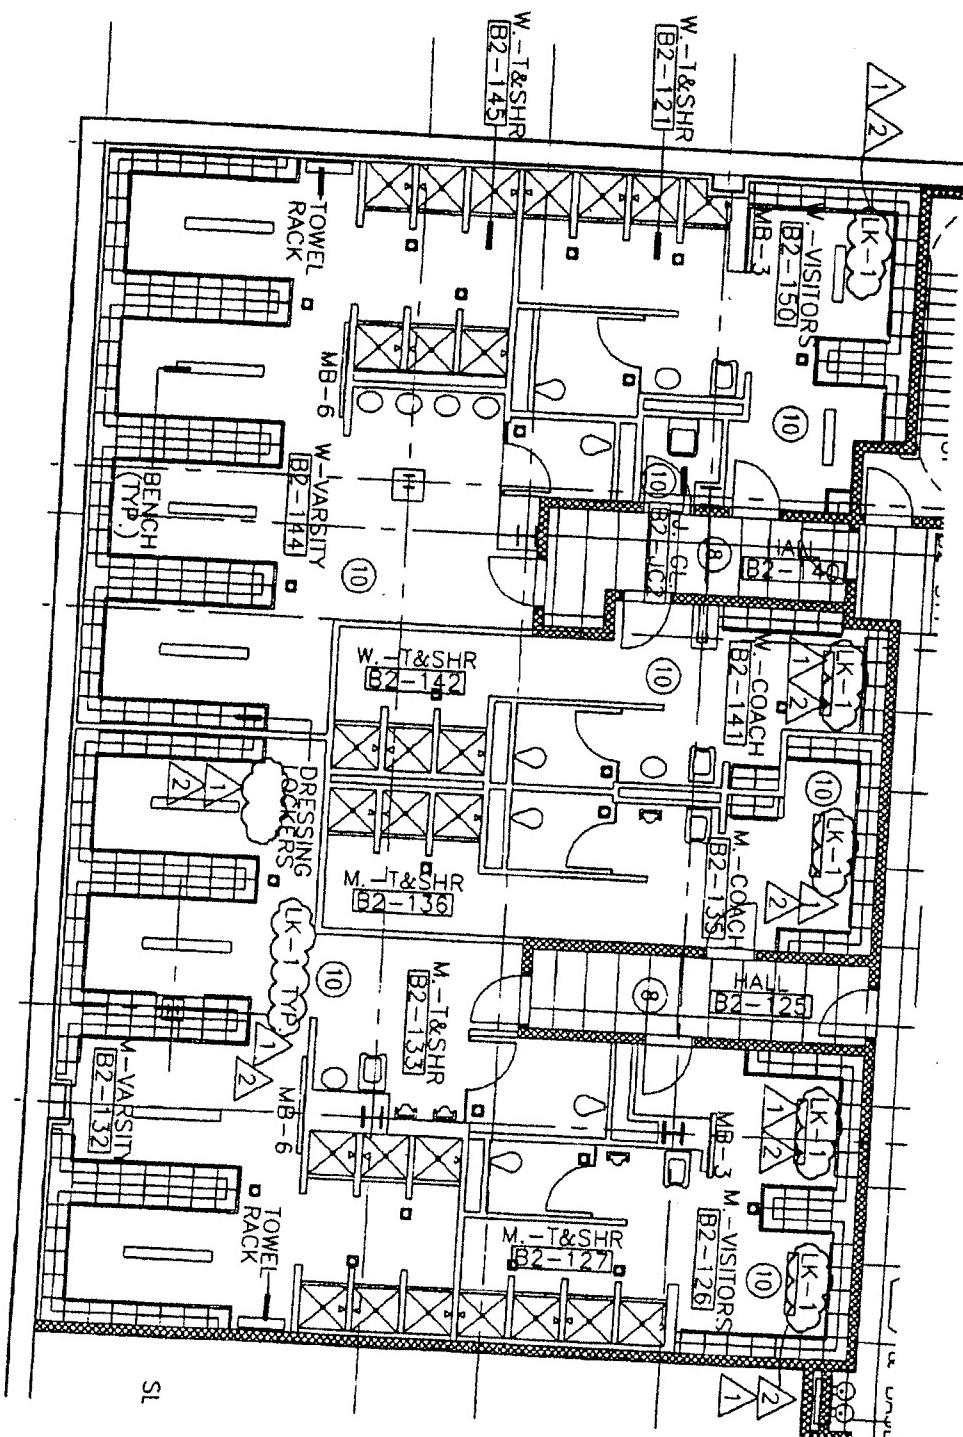

Baruch Academic Complex - Site B

55 LEXINGTON AVENUE NEW YORK, NY 10010

OWNER

OWNER
DORMITORY AUTHORITY OF THE STATE OF NEW YORK, DA# 6500 1802 2178
1 PENNSYLVANIA PLAZA NEW YORK, NY 10119

ARCHITECT
KPF ASSOCIATES
11 WEST 57TH STREET
NEW YORK, NY 10019

REF. DETAIL/SHEET NO. SKETCH NO.


A-142

SKETCH NO.

SCALE NTS

sk-1317

NEW YORK, NY 10119		REF. DETAIL/SHEET NO.
NO.	REVISION	DATE
2	ACCEDEMUM #2 (CONTRACT #16)	6/5/98

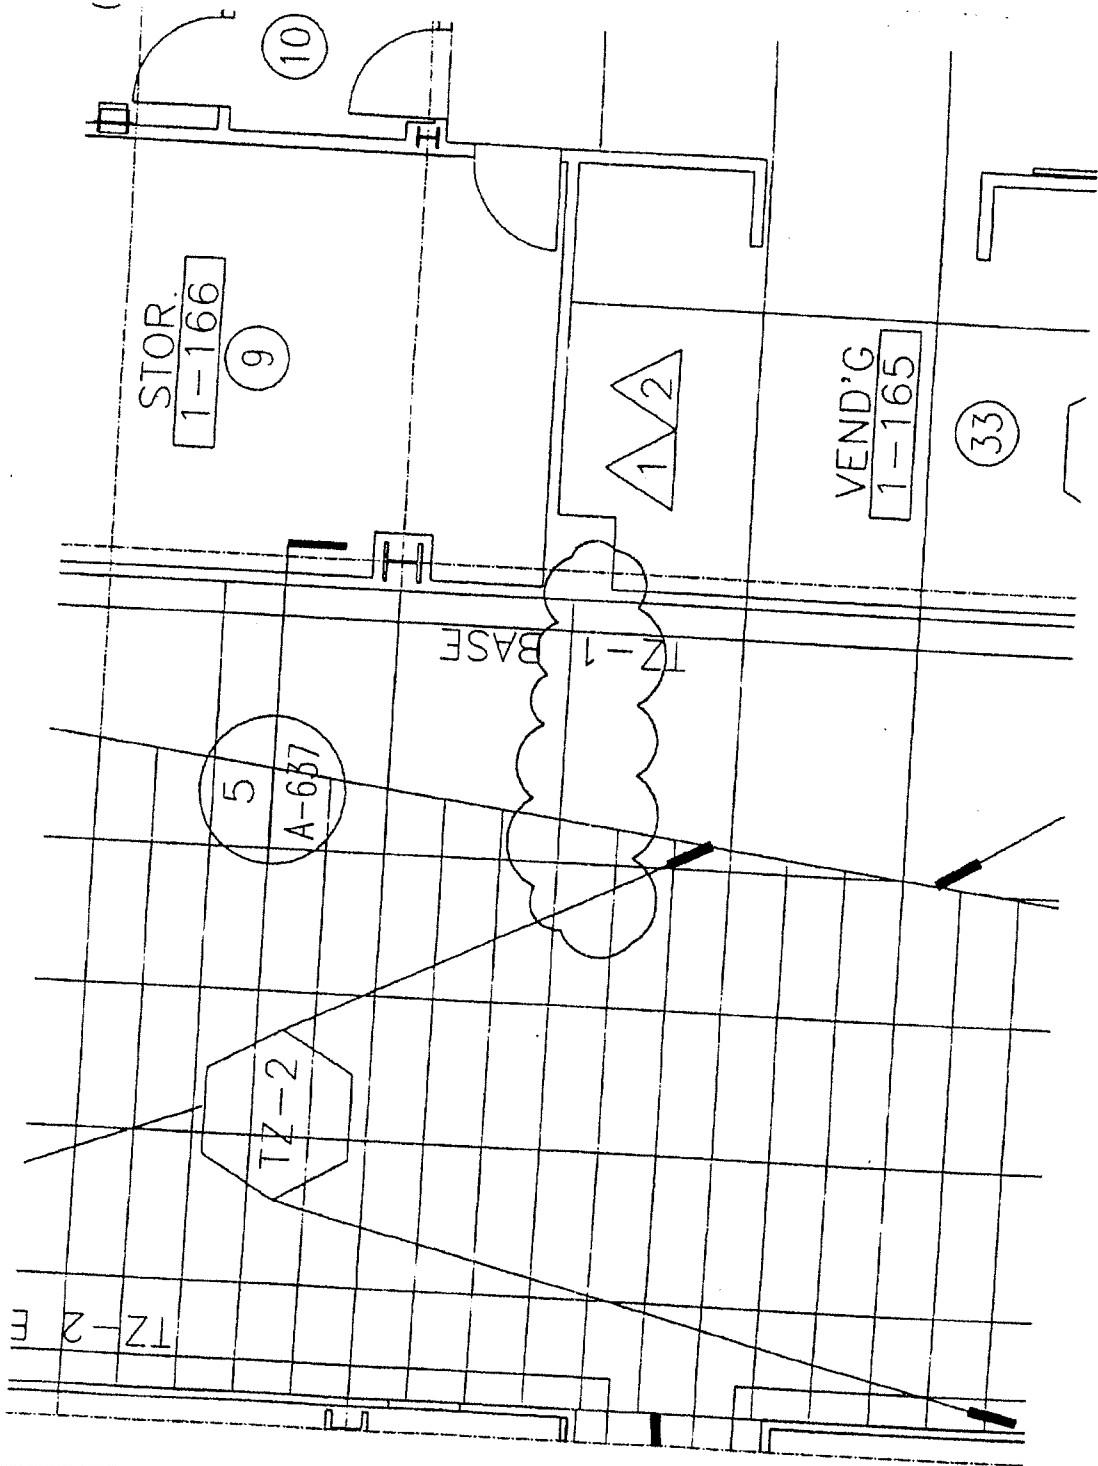

Baruch Academic Complex - Site B

55 LEXINGTON AVENUE

NEW YORK, NY 10010

OWNER


DORMITORY AUTHORITY OF THE STATE OF NEW YORK, DA# 6500 1802 2178
1 PENNSYLVANIA PLAZA

NEW YORK, NY 10119

ARCHITECT
KPF ASSOCIATES
11 WEST 57TH STREET
NEW YORK, NY 10019

REF. DETAIL/SHEET NO.	SKETCH NO.
A-144	SK-13B

NO.	REVISION	DATE	SCALE
2	ADDENDUM #2 (CONTRACT #16)	6/5/98	NTS

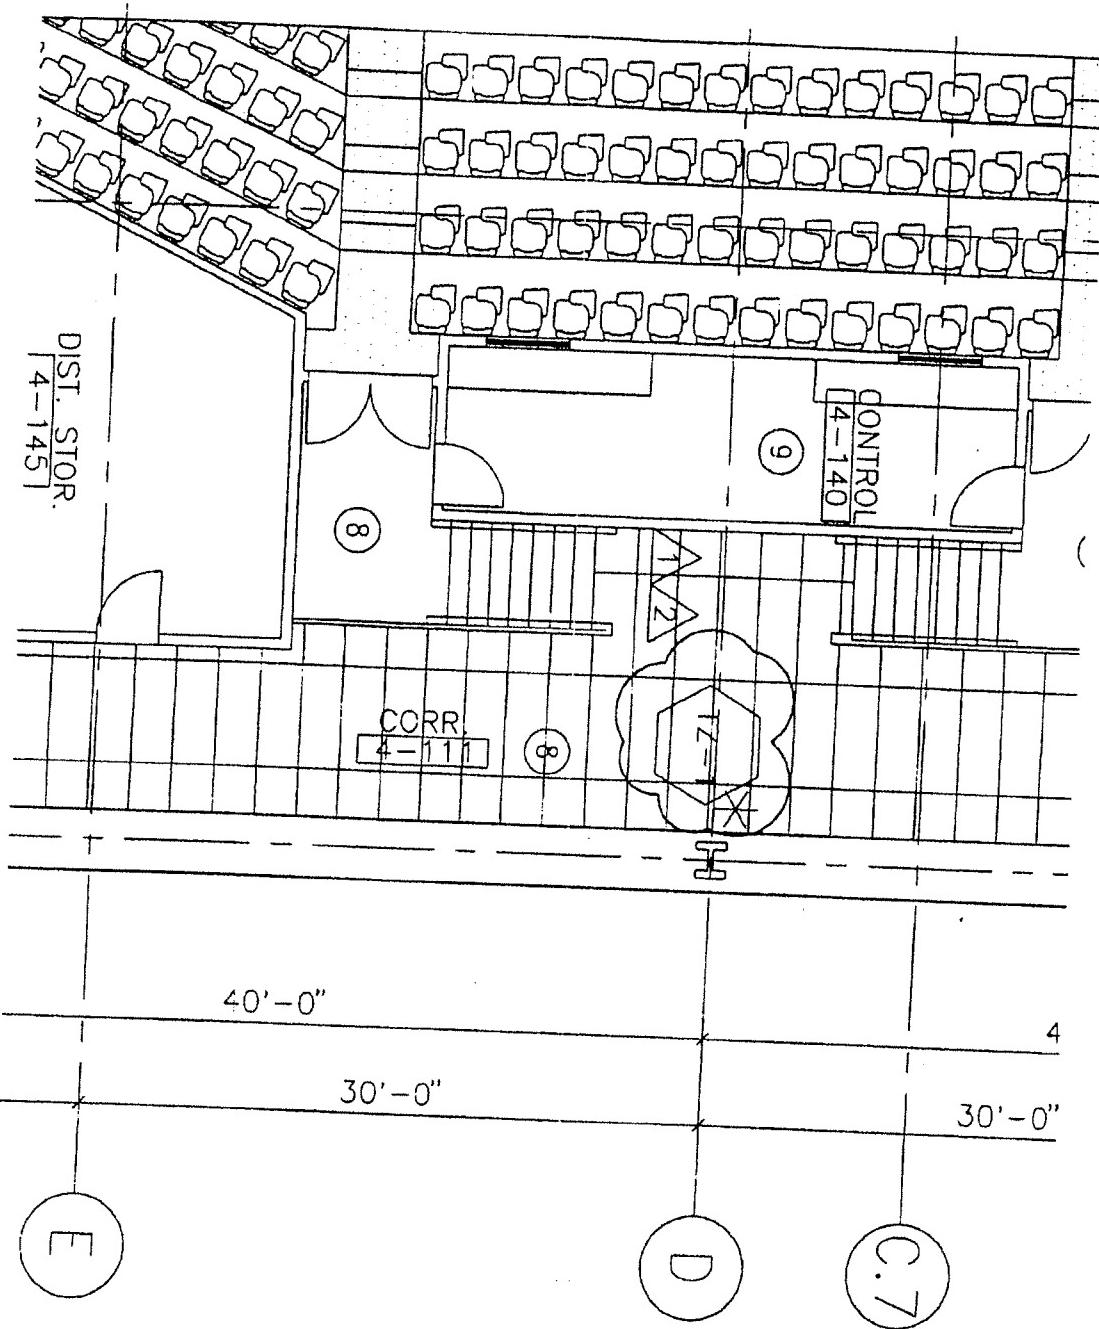

Baruch Academic Complex - Site B

55 LEXINGTON AVENUE NEW YORK, NY 10010

OWNER


DORMITORY AUTHORITY OF THE STATE OF NEW YORK, DA# 6500 1802 2178
1 PENNSYLVANIA PLAZA NEW YORK, NY 10119

ARCHITECT
KPF ASSOCIATES
11 WEST 57TH STREET
NEW YORK, NY 10019

REF. DETAIL/SHEET NO.
A1-147

SKETCH NO.

NO.	REVISION	DATE	SCALE
2	ADDENDUM #2 (CONTRACT #16)	6/5/98	NTS

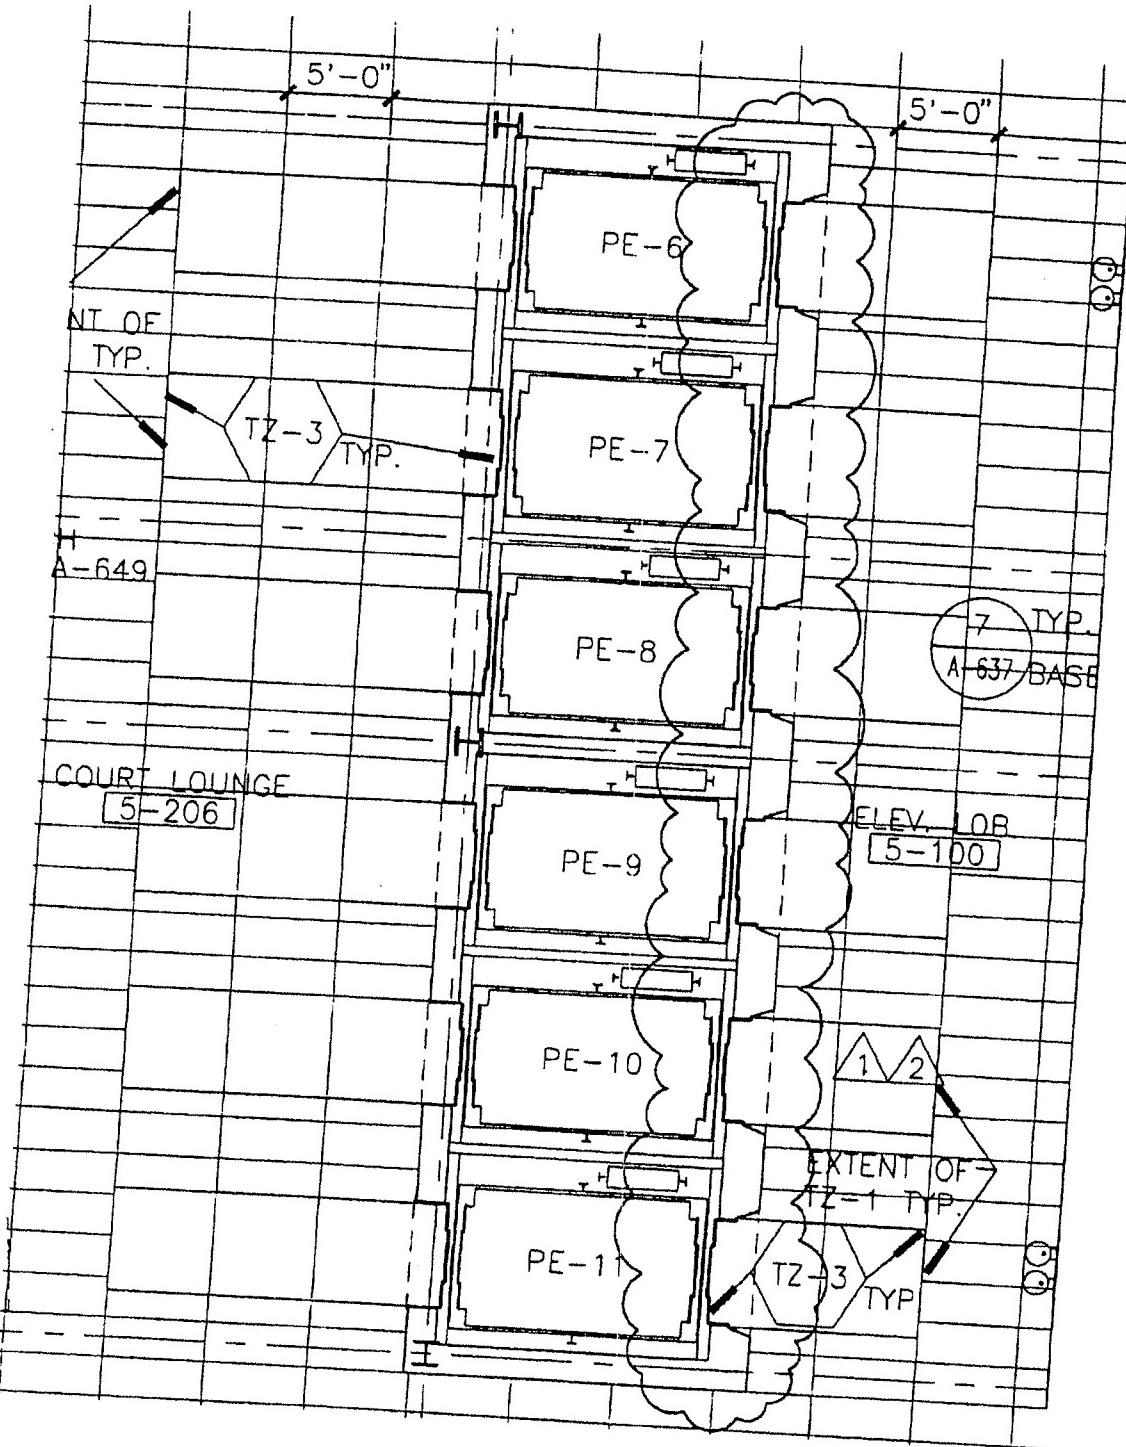

Baruch Academic Complex - Site B


55 LEXINGTON AVENUE NEW YORK, NY 10010

ARCHITECT
KPF ASSOCIATES
11 WEST 57TH STREET
NEW YORK, NY 10019

OWNER
CORMITORY AUTHORITY OF THE STATE OF NEW YORK, DA# 6500 1802 2178
1 PENNSYLVANIA PLAZA NEW YORK, NY 10119

REF. DETAIL/SHEET NO.	SKETCH NO.
A-148	
SCALE	5K-1320
NTS	

NO.	REVISION	DATE
2	ADDENDUM #2 (CONTRACT #16)	6/5/98

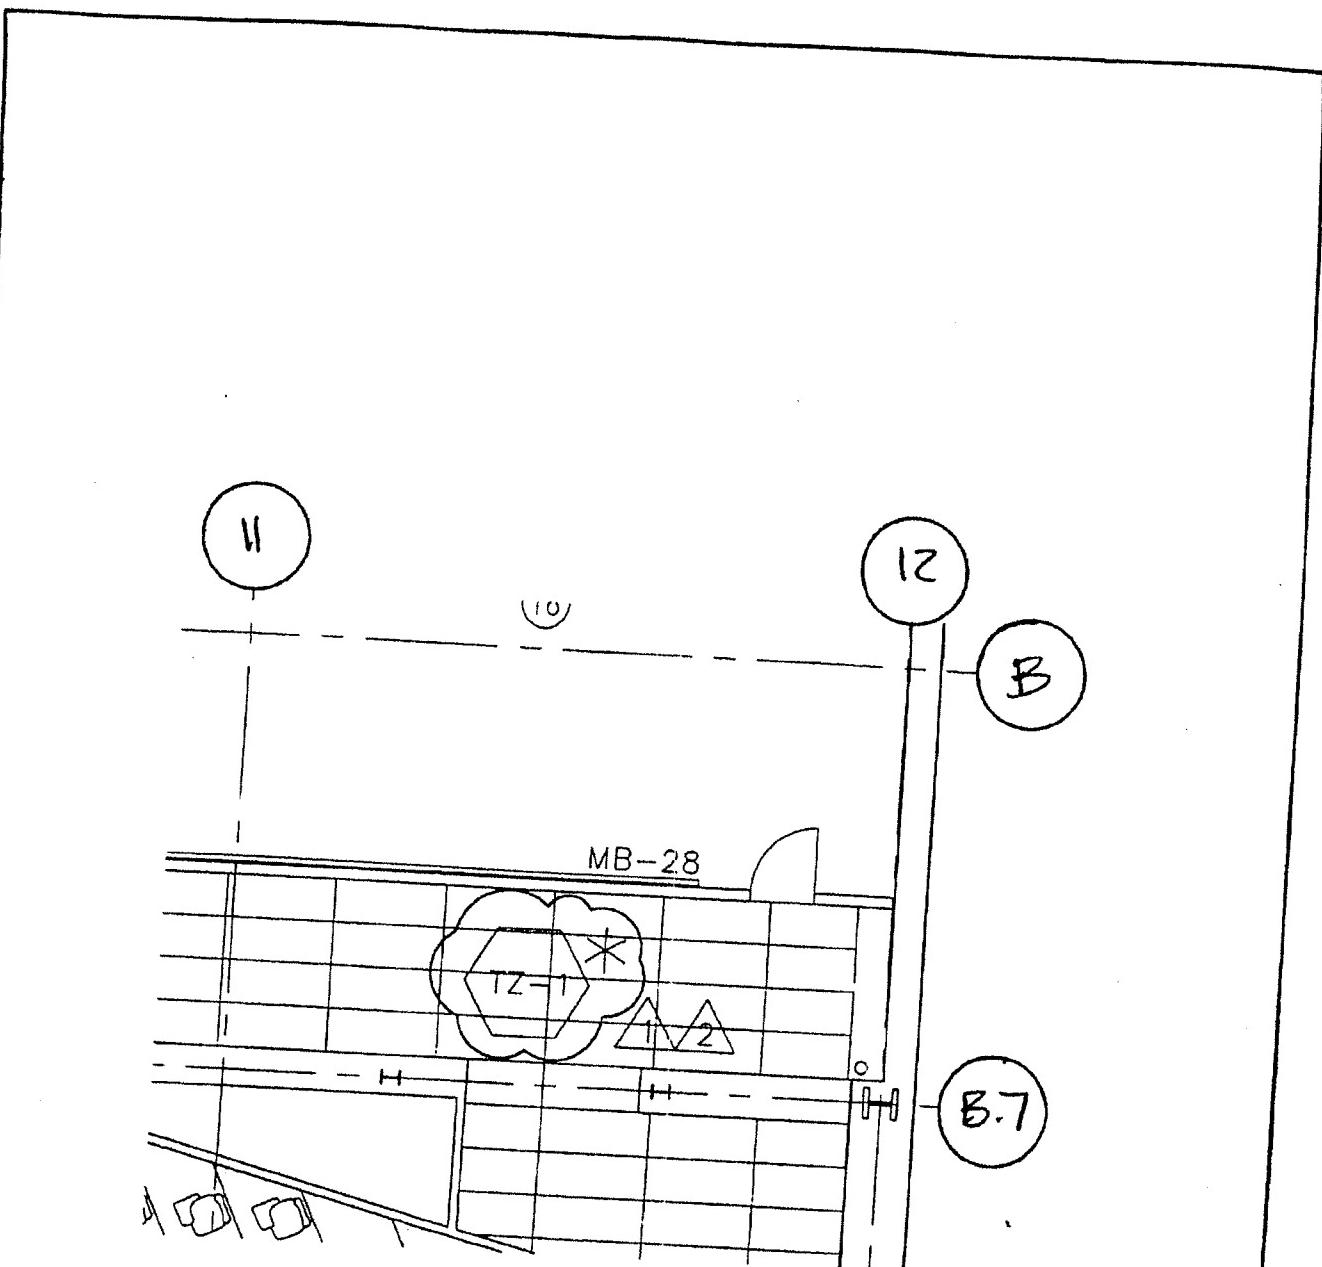

Baruch Academic Complex - Site B


55 LEXINGTON AVENUE
NEW YORK, NY 10010

OWNER
DORMITORY AUTHORITY OF THE STATE OF NEW YORK, DA# 6500 1802 2178
1 PENNSYLVANIA PLAZA
NEW YORK, NY 10119

ARCHITECT
KPF ASSOCIATES
11 WEST 57TH STREET
NEW YORK, NY 10019

REF. DETAIL/SHEET NO.	SKETCH NO.
A-148	SK-1321
SCALE	$1/8'' = 1'-0''$

NO.	REVISION	DATE
2	ADDENDUM #2 (CONTRACT #16)	6/5/98

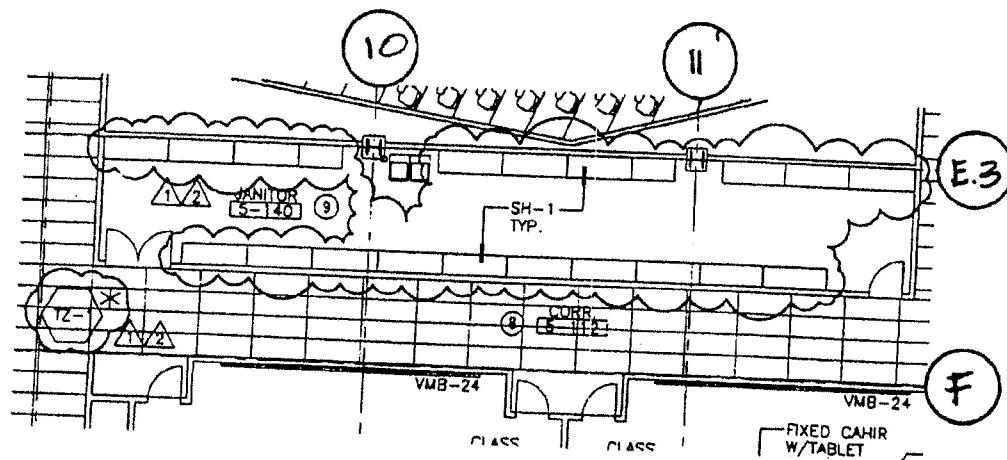

Baruch Academic Complex - Site B

55 Lexington Avenue

NEW YORK, NY 10010

ARCHITECT

KPF ASSOCIATES
11 WEST 57TH STREET
NEW YORK, NY 10019

OWNER
DORMITORY AUTHORITY OF THE STATE OF NEW YORK, DA # 6500 1802 2178
1 PENNSYLVANIA PLAZA NEW YORK, NY 10119

REF. DETAIL/SHEET NO.

A-148

SKETCH NO

SCALE

1 1/16" = 1'-0"

SK-1322

NO.


REVISION

DATE

2

ADDENDUM #2 (CONTRACT #16)

6/5/98

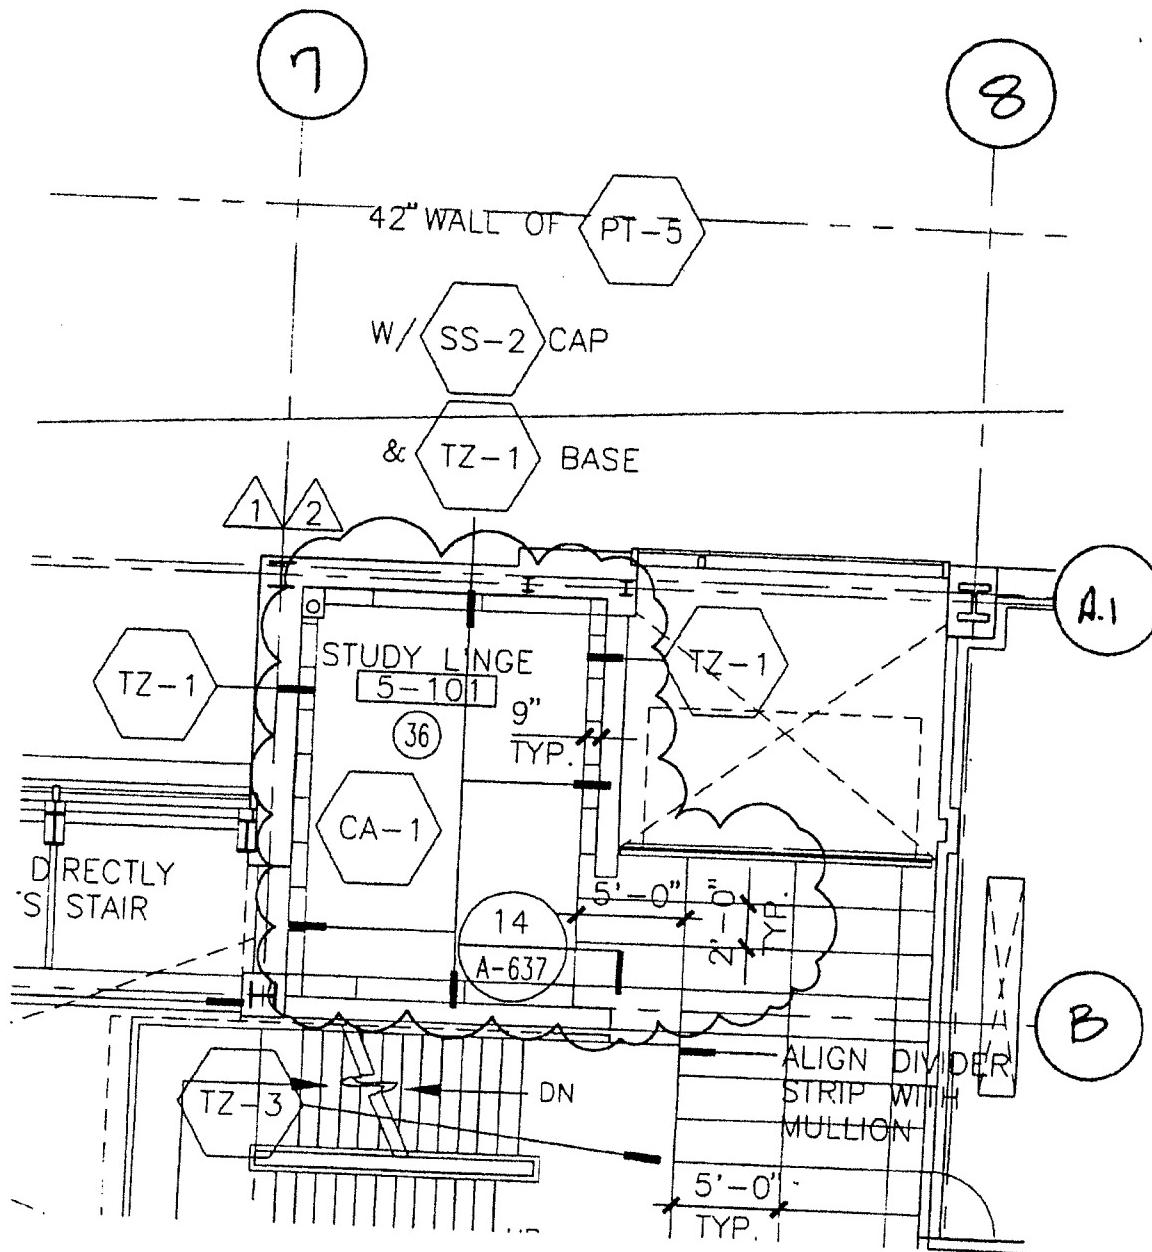

Baruch Academic Complex - Site B

55 Lexington Avenue

New York, NY 10010

ARCHITECT

KPF ASSOCIATES

11 West 57th Street

New York, NY 10019

REF. DETAIL/SHEET NO.

A-148

SKETCH NO.

MORTORY AUTHORITY OF THE STATE OF NEW YORK, DA# 6500 1802 2178
1 PENNSYLVANIA PLAZA NEW YORK, NY 10119

NO.

REVISION

DATE



SCALE

1/8" = 1'-0" SK. 1323

2

ADDENDUM #2 (CONTRACT #16)

6/5/98

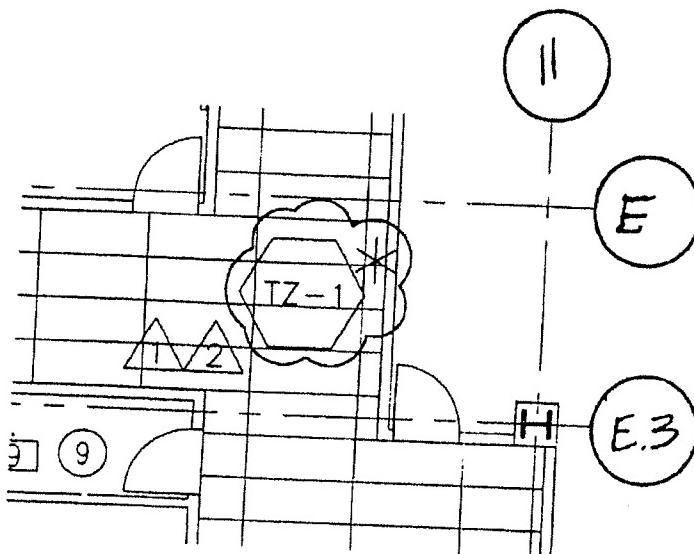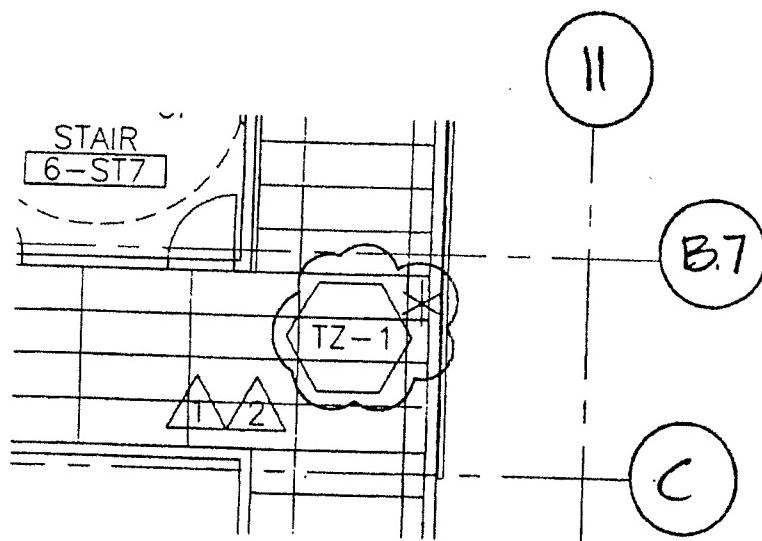

Baruch Academic Complex - Site B

55 LEXINGTON AVENUE

NEW YORK, NY 10010

ARCHITECT

KPF ASSOCIATES

11 WEST 57TH STREET
NEW YORK, NY 10019

OWNER
DORMITORY AUTHORITY OF THE STATE OF NEW YORK, DA# 6500 1802 2178
1 PENNSYLVANIA PLAZA NEW YORK, NY 10119

REF. DETAIL/SHEET NO.

A-149

SKETCH NO.

NO.

REVISION

DATE

2


ADDENDUM #2 (CONTRACT #16)

6/5/98

SCALE

1/8" = 1'-0"

sk-1324

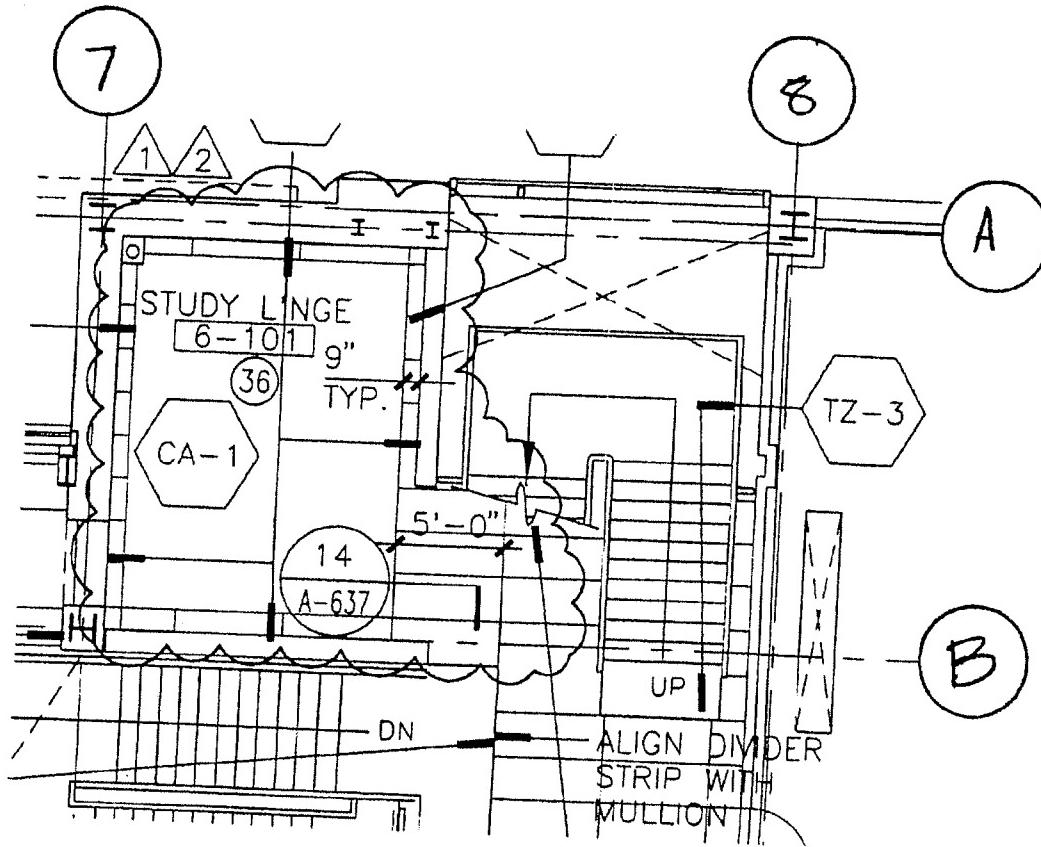

Baruch Academic Complex - Site B

55 Lexington Avenue

NEW YORK, NY 10010

ARCHITECT

KPF ASSOCIATES

11 WEST 57TH STREET
NEW YORK, NY 10019

REF. DETAIL/SHEET NO.


A-149

SKETCH NO.

~~SK~~-1325

OWNER
DORMITORY AUTHORITY OF THE STATE OF NEW YORK, DA# 5500 1802 2178
1 PENNSYLVANIA PLAZA NEW YORK, NY 10119

NO.	REVISION	DATE
2	ADDENDUM #2 (CONTRACT #16)	6/5/98

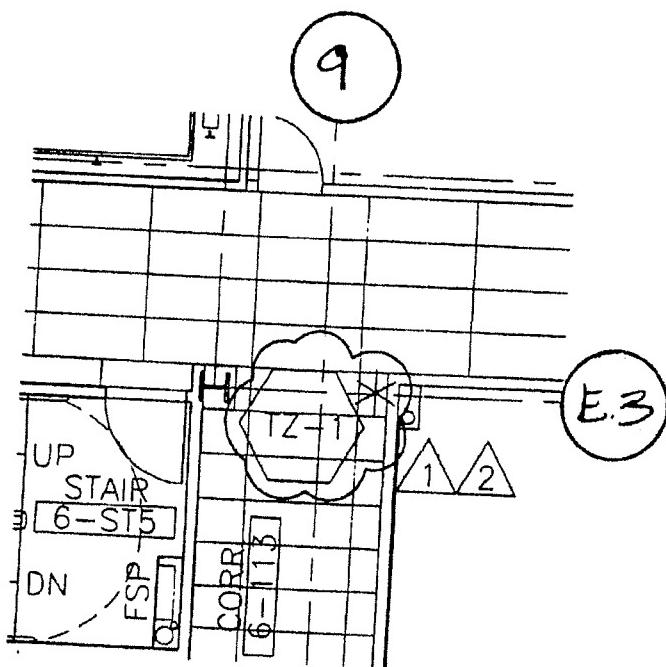

Baruch Academic Complex - Site B

55 LEXINGTON AVENUE

NEW YORK, NY 10010

OWNER

DORMITORY AUTHORITY OF THE STATE OF NEW YORK, DA# 6500 1802 2178
1 PENNSYLVANIA PLAZA NEW YORK, NY 10119

ARCHITECT

KPF ASSOCIATES
11 WEST 57TH STREET
NEW YORK, NY 10019



REF. DETAIL/SHEET NO.

A-149

SKETCH NO.

SK-1326

NO.	REVISION	DATE	SCALE
2	ADDENDUM #2 (CONTRACT #16)	6/5/98	1/8" = 1'-0"

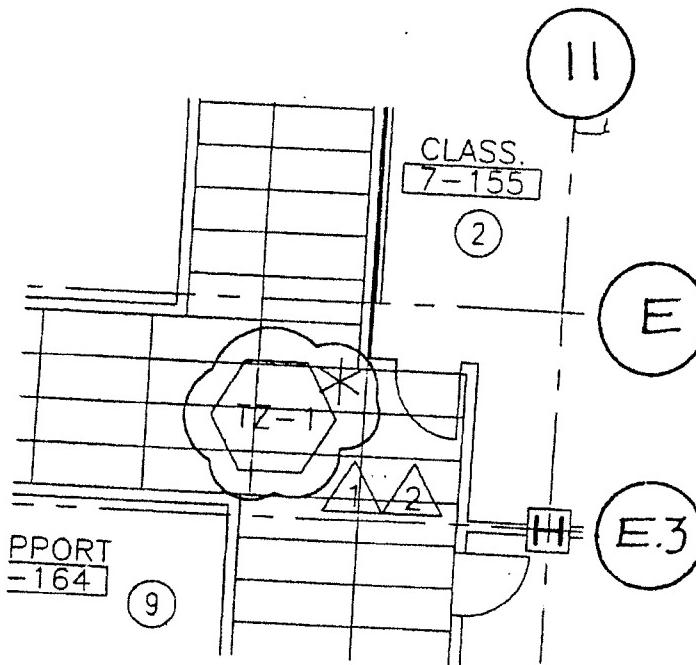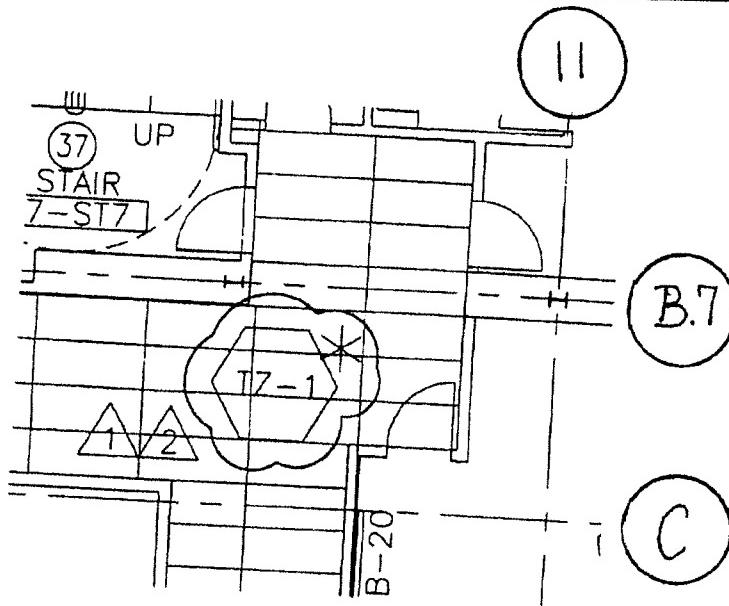

Baruch Academic Complex - Site B

55 LEXINGTON AVENUE

NEW YORK, NY 10010

OWNER

DORMITORY AUTHORITY OF THE STATE OF NEW YORK, DA# 6500 1802 2178
1 PENNSYLVANIA PLAZA NEW YORK, NY 10119

ARCHITECT

KPF ASSOCIATES
11 WEST 57TH STREET
NEW YORK, NY 10019


REF. DETAIL/SHEET NO.

A-150

SKETCH NO.

sk.1321

NO.	REVISION	DATE	SCALE
	ADDENDUM #2 (CONTRACT #16)	6/5/98	11'8" = 11'-0"

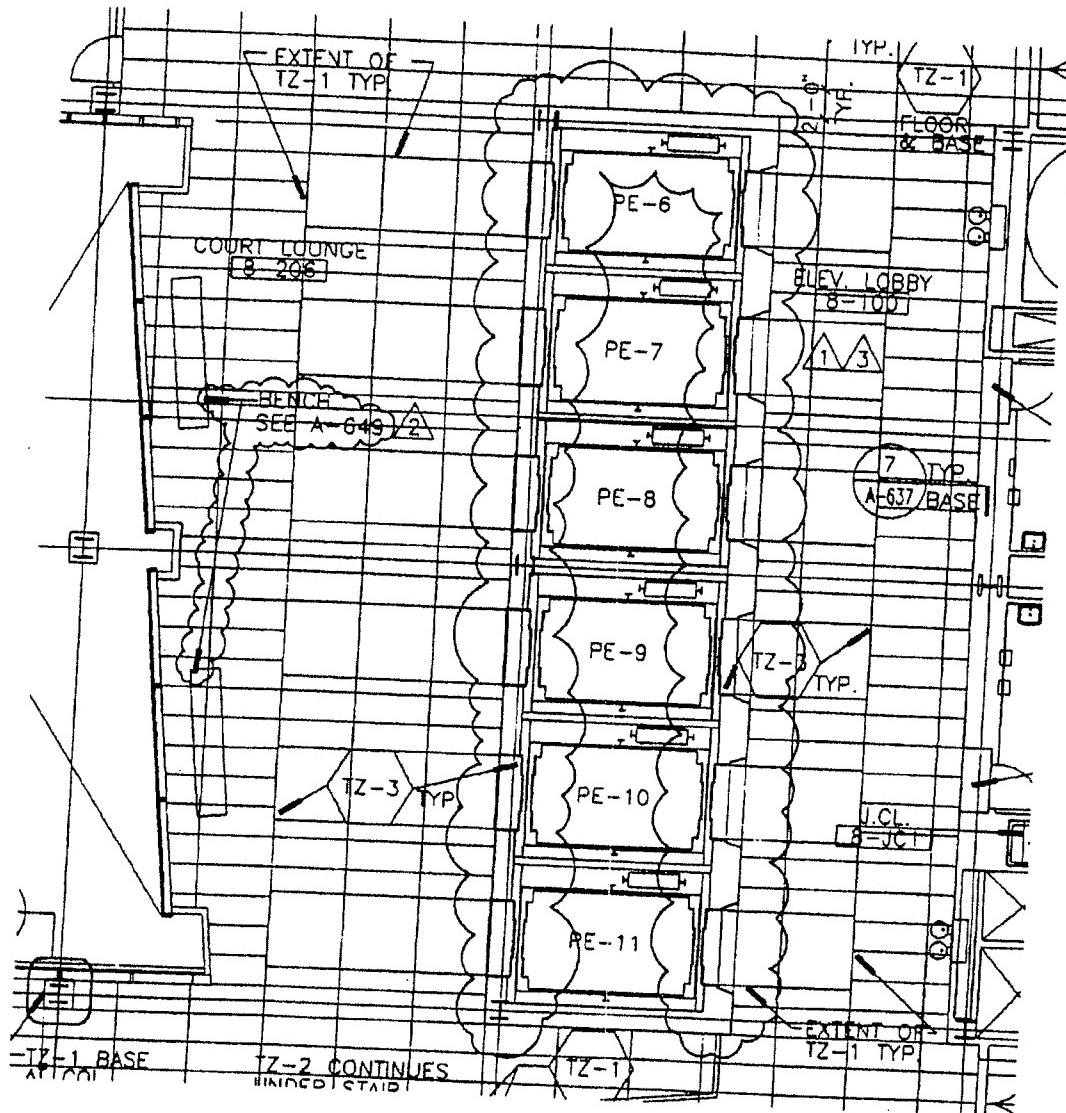

Baruch Academic Complex - Site B

55 LEXINGTON AVENUE NEW YORK, NY 10010

OWNER

DORMITORY AUTHORITY OF THE STATE OF NEW YORK, DA# 6500 1802 2178
1 PENNSYLVANIA PLAZA NEW YORK, NY 10119

ARCHITECT:
KPF ASSOCIATES
11 WEST 57TH STREET
NEW YORK, NY 10019

REF. DETAIL/SHEET NO.

A 1151

SKETCH NO.

NO.

REVISION


DATE

6/5/98

SCALE

NTS

SK-1328

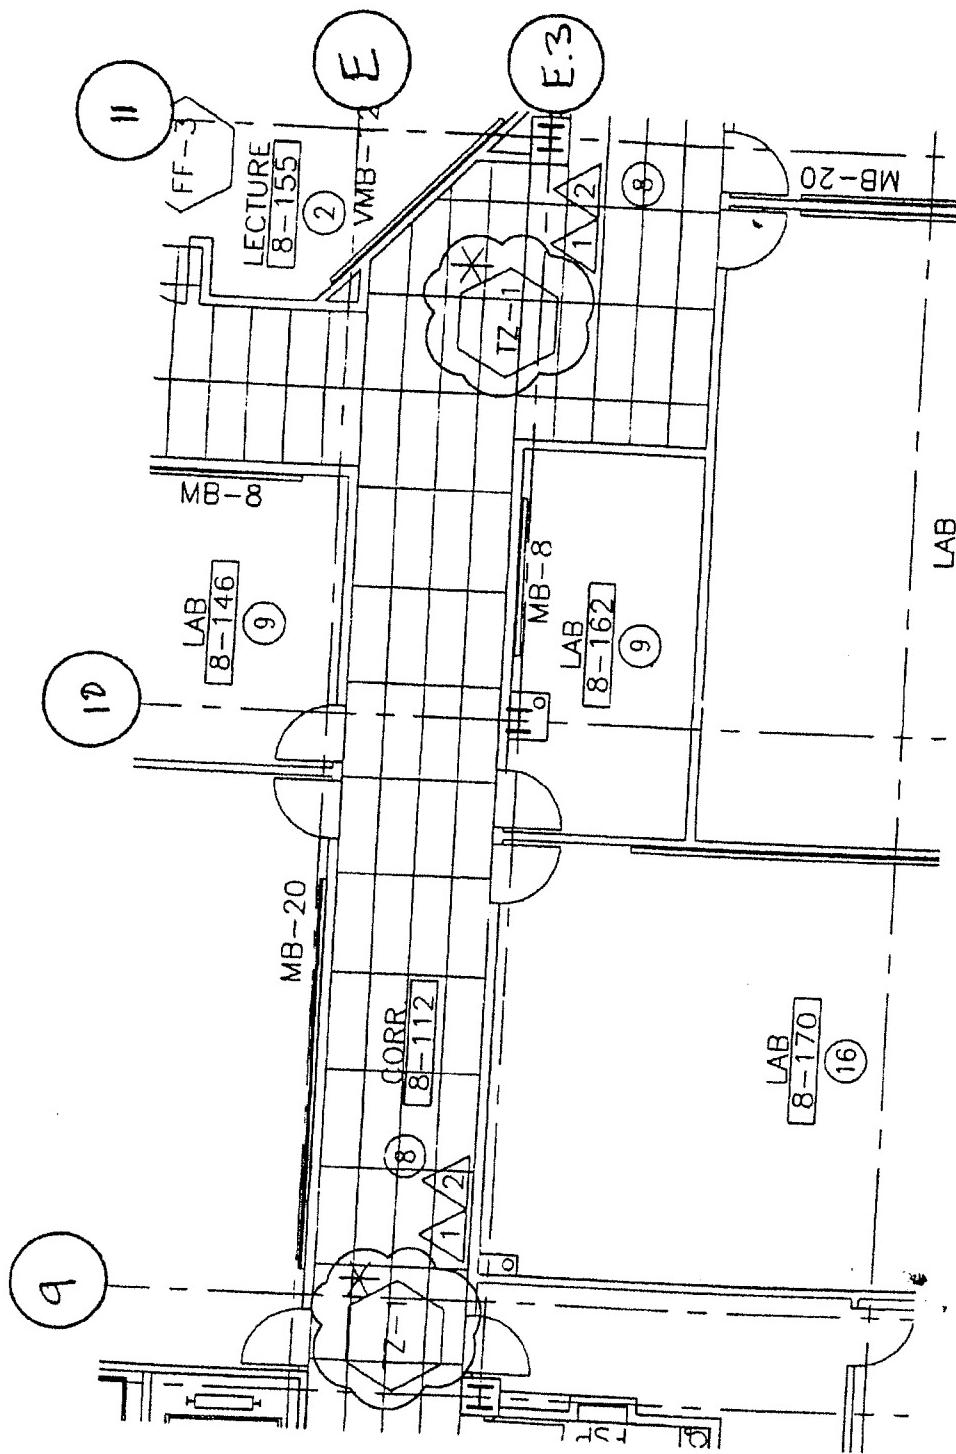

Baruch Academic Complex - Site B

55 Lexington Avenue NEW YORK, NY 10010


OWNER

DORMITORY AUTHORITY OF THE STATE OF NEW YORK, DA# 6500 1802 2178
1 PENNSYLVANIA PLAZA NEW YORK, NY 10119

ARCHITECT
KPF ASSOCIATES
11 WEST 57TH STREET
NEW YORK, NY 10019

REF. DETAIL/SHEET NO.	SKETCH NO.
A-151	SK-1329

NO.	REVISION	DATE	SCALE
2	ADDENDUM #2 (CONTRACT #16)	6/5/98	1/8"=1'-0"

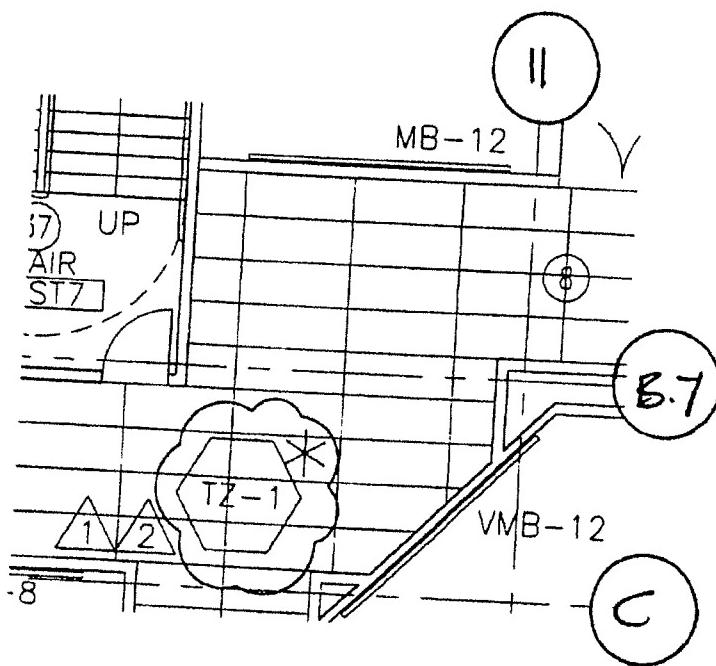

Baruch Academic Complex - Site B

55 Lexington Avenue

NEW YORK, NY 10010

OWNER

JORMITORY AUTHORITY OF THE STATE OF NEW YORK, DA# 65CO 1802 2178
1 PENNSYLVANIA PLAZA NEW YORK, NY 10119

ARCHITECT

KPF ASSOCIATES

11 WEST 57TH STREET
NEW YORK, NY 10019

REF. DETAIL/SHEET NO.

A-151

SKETCH NO.

SK-1330

NO.



REVISION

DATE

6/5/98

SCALE

1/8" = 1'-0"

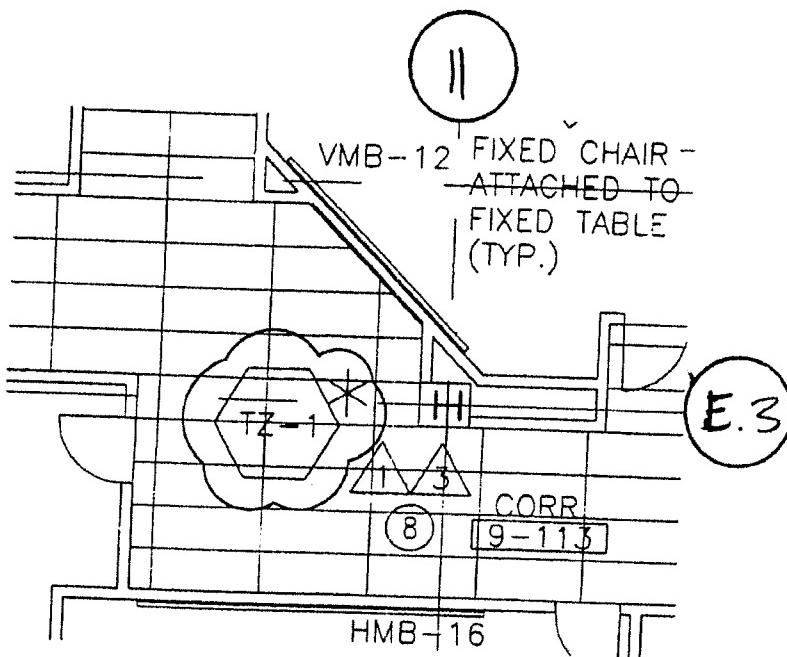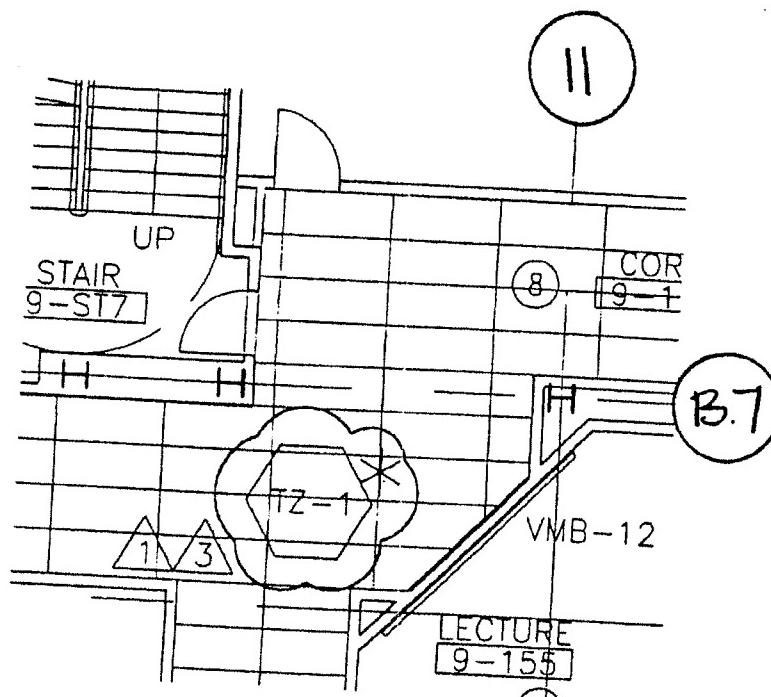

Baruch Academic Complex - Site B

55 LEXINGTON AVENUE

NEW YORK, NY 10010

ARCHITECT


KPF ASSOCIATES

11 WEST 57TH STREET



NEW YORK, NY 10019

OWNER
DORMITORY AUTHORITY OF THE STATE OF NEW YORK, DA# 6500 1802 2178
1 PENNSYLVANIA PLAZA NEW YORK, NY 10119

NO.	REVISION	DATE	REF. DETAIL/SHEET NO.	SKETCH NO.
3	ADDENDUM #2 (CONTRACT #16)	6/5/98	A-152 1/8" = 1'-0"	Sk-1331

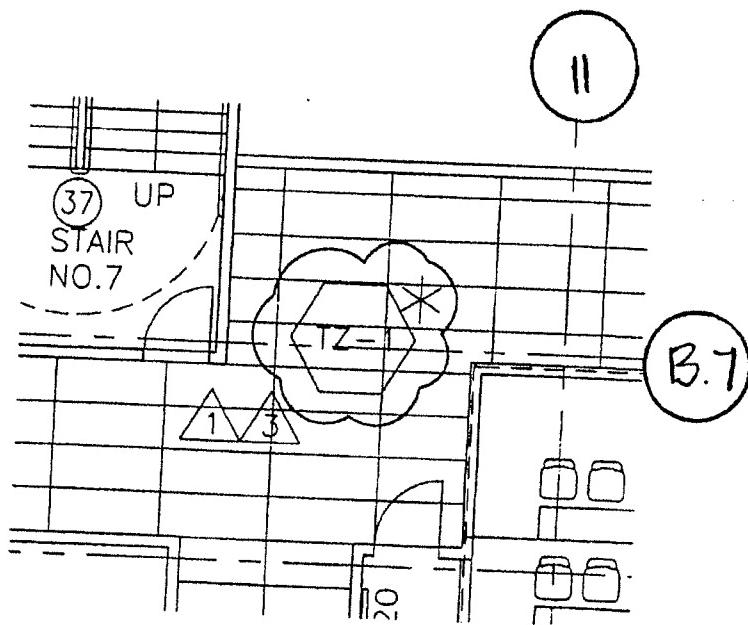

Baruch Academic Complex - Site B			ARCHITECT KPF ASSOCIATES 11 WEST 57TH STREET NEW YORK, NY 10019
55 LEXINGTON AVENUE NEW YORK, NY 10010 OWNER JURISDICTIONAL AUTHORITY OF THE STATE OF NEW YORK, DA# 6500 1802 2178 1 PENNSYLVANIA PLAZA NEW YORK, NY 10119			REF. DETAIL/SHEET NO. A-153
NO.	REVISION	DATE	SKETCH NO. SK-1332
'3	ADDENDUM #2 (CONTRACT #16)	6/5/98	SCALE 1/8" = 1'-0"

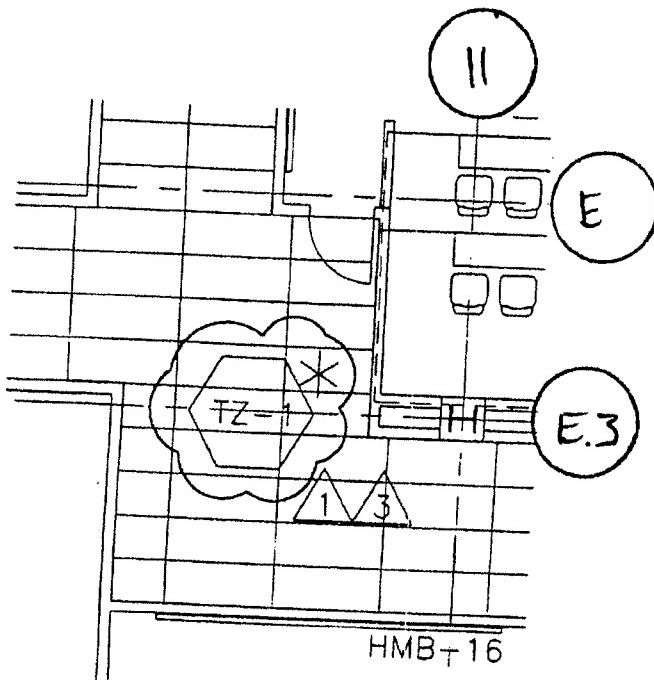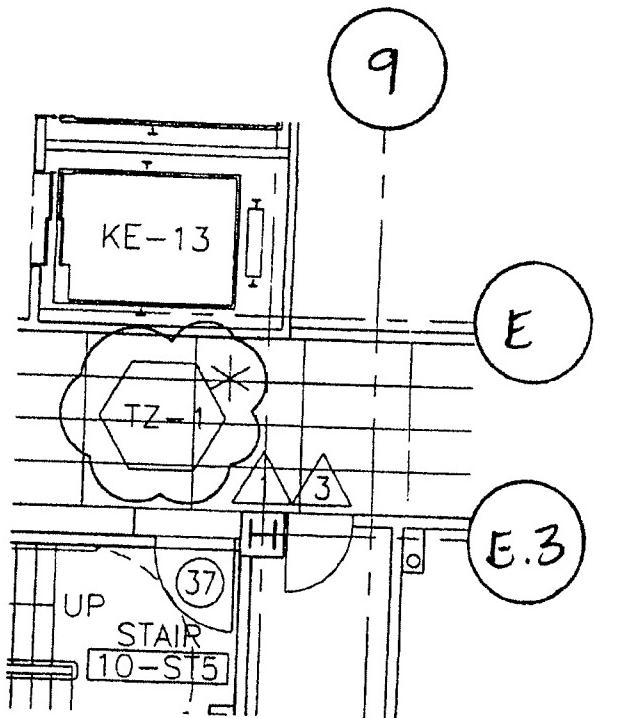

Baruch Academic Complex - Site B

55 LEXINGTON AVENUE

NEW YORK, NY 10010

ARCHITECT

KPF ASSOCIATES

11 WEST 57TH STREET
NEW YORK, NY 10019

OWNER
DORMITORY AUTHORITY OF THE STATE OF NEW YORK, DA# 6500 1802 2178
1 PENNSYLVANIA PLAZA NEW YORK, NY 10119

REF. DETAIL/SHEET NO.

A-153

SKETCH NO.

SK-1333

NO.


REVISION

DATE

3

ADDENDUM #2 (CONTRACT #16)

6/5/98

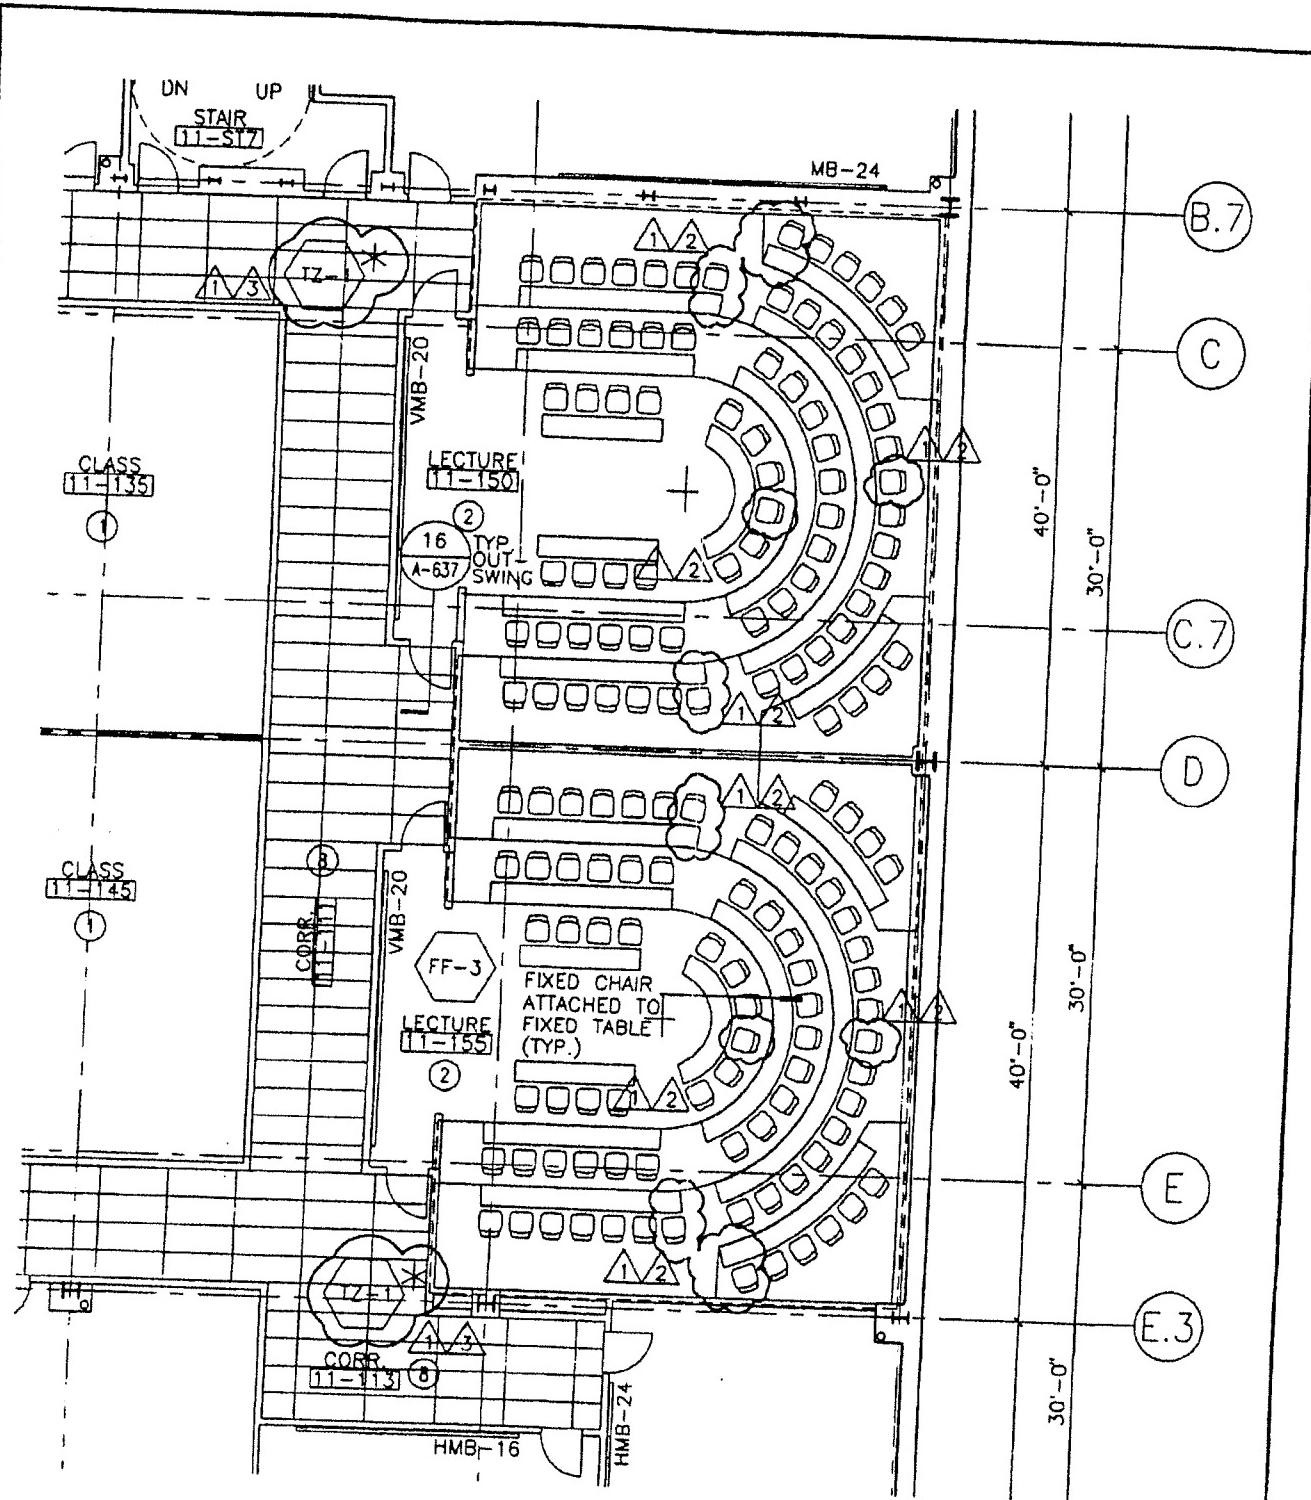

Baruch Academic Complex - Site B

55 LEXINGTON AVENUE


NEW YORK, NY 10010

OWNER
DORMITORY AUTHORITY OF THE STATE OF NEW YORK, DA# 6500 1802 2178
1 PENNSYLVANIA PLAZA NEW YORK, NY 10119

ARCHITECT
KPF ASSOCIATES
11 WEST 57TH STREET
NEW YORK, NY 10019

REF. DETAIL/SHEET NO.	SKETCH NO.
A/154	SK-1334
SCALE	N.T.S.

NO.	REVISION	DATE
3	ADDENDUM #2 (CONTRACT #16)	6/5/98

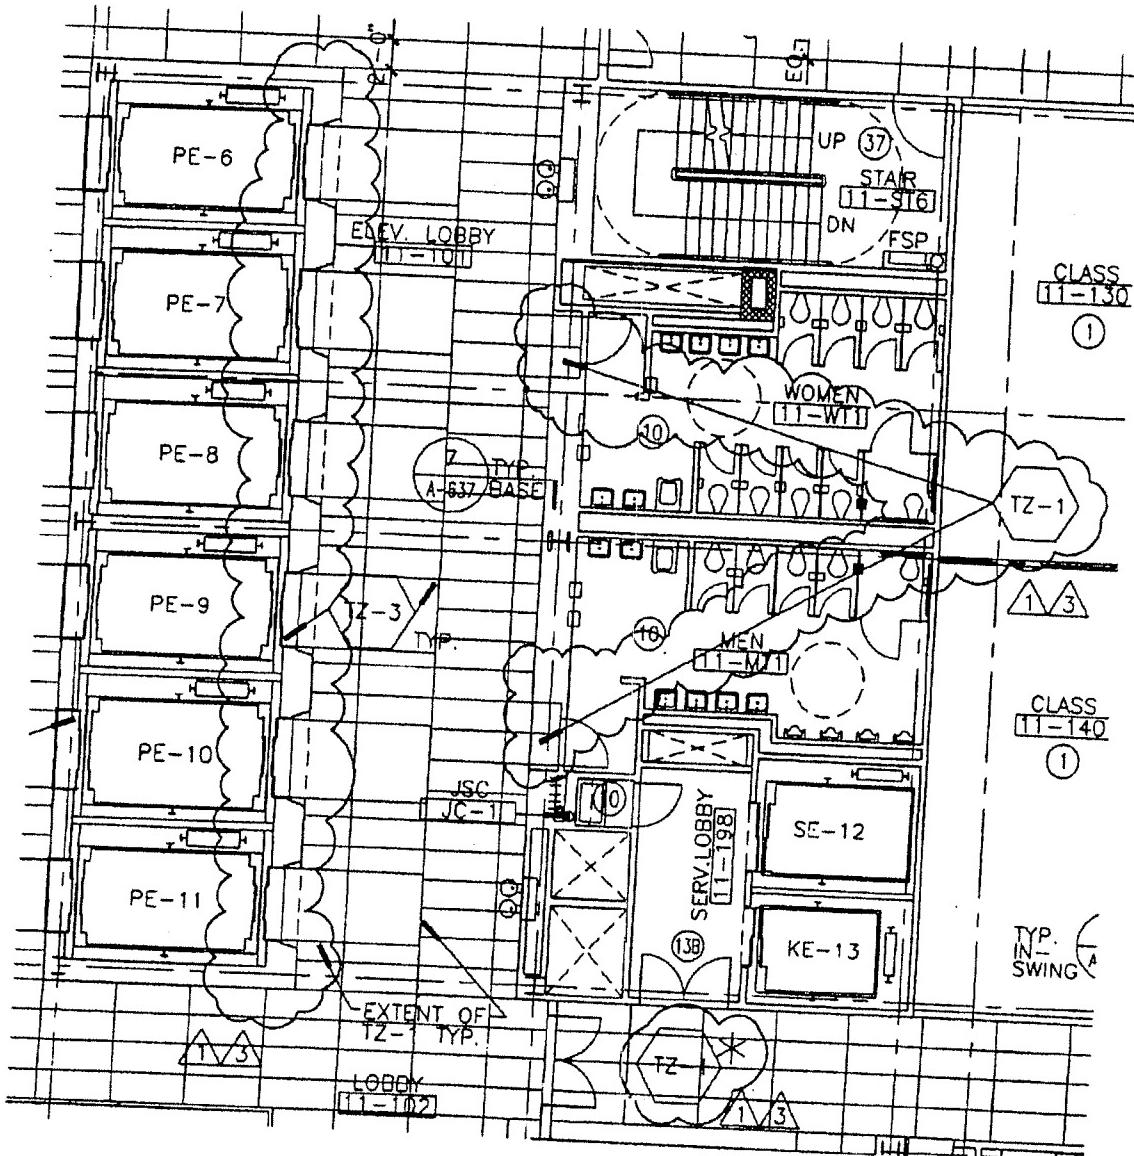

Baruch Academic Complex - Site B
55 LEXINGTON AVENUE NEW YORK, NY 10010


OWNER

DORMITORY AUTHORITY OF THE STATE OF NEW YORK, DA# 6500 1802 2178
1 PENNSYLVANIA PLAZA NEW YORK, NY 10119

ARCHITECT
KPF ASSOCIATES
11 WEST 57TH STREET
NEW YORK, NY 10019

REF. DETAIL/SHEET NO.	SKETCH NO.
A/A - 154	SK. 1335
SCALE	N.T.S.

NO.	REVISION	DATE
3	ADDENDUM #2 (CONTRACT #16)	6/5/98

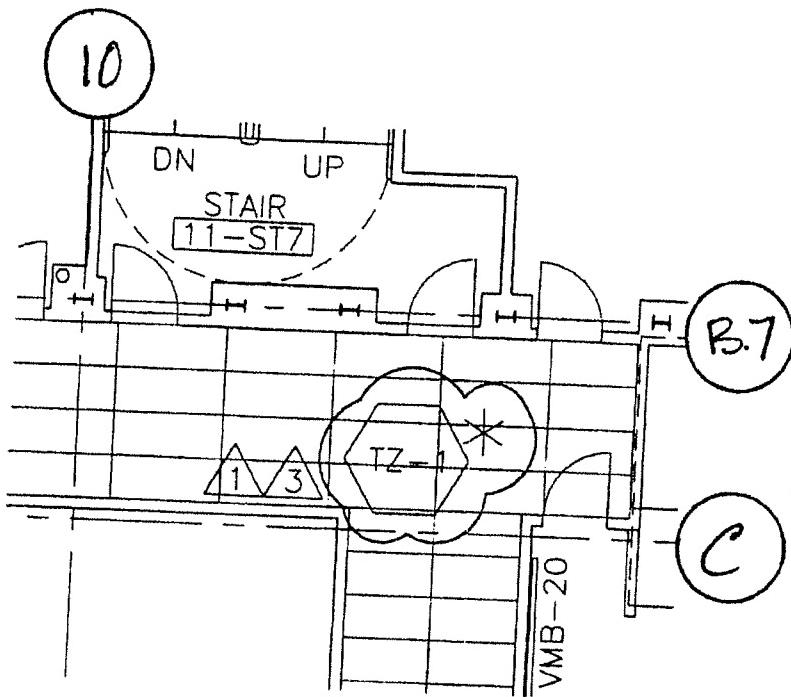

Baruch Academic Complex - Site B

55 LEXINGTON AVENUE NEW YORK, NY 10010

OWNER

DORMITORY AUTHORITY OF THE STATE OF NEW YORK, DA# 6500 1802 2178
1 PENNSYLVANIA PLAZA NEW YORK, NY 10119

ARCHITECT

KPF ASSOCIATES
11 WEST 57TH STREET
NEW YORK, NY 10019

REF. DETAIL/SHEET NO.

A-154

SKETCH NO.

sk-1336

NO.



REVISION

DATE

3 ADDENDUM #2 (CONTRACT #16) 6/5/98

SCALE

1/8" = 1'-0"

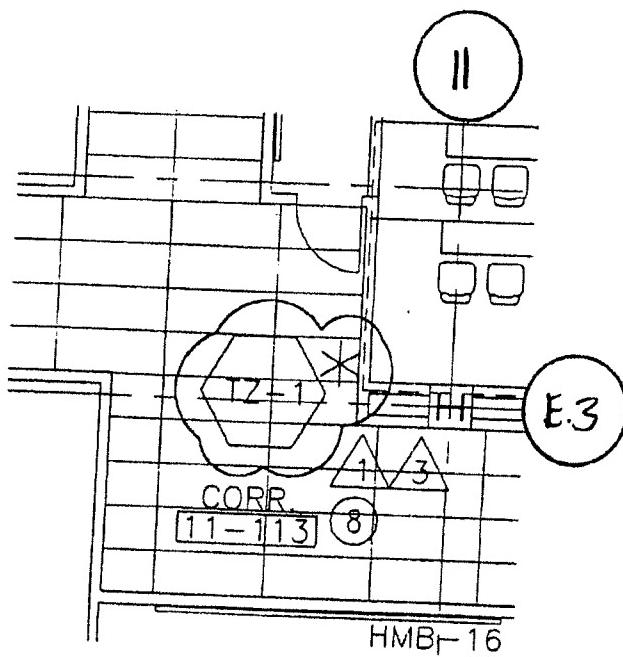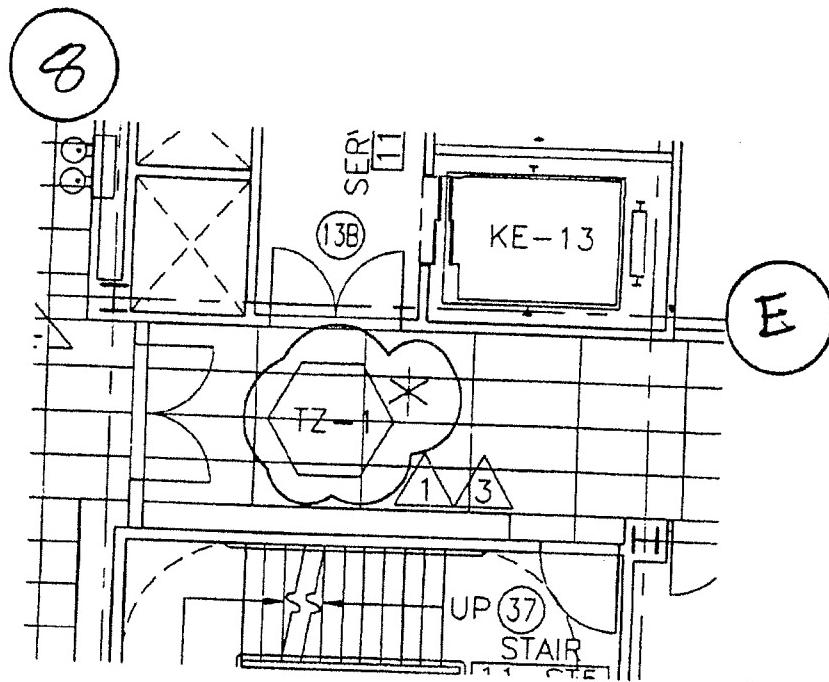

Baruch Academic Complex - Site B

55 Lexington Avenue NEW YORK, NY 10010

OWNER

JORMITORY AUTHORITY OF THE STATE OF NEW YORK, DA# 65CC 1802 2178
1 PENNSYLVANIA PLAZA NEW YORK, NY 10119

ARCHITECT

KPF ASSOCIATES
11 WEST 57TH STREET
NEW YORK, NY 10019

REF. DETAIL/SHEET NO.

A-154

SKETCH NO.

SK-1337

NO.



REVISION

DATE

3

ADDENDUM #2 (CONTRACT #16)

6/5/98

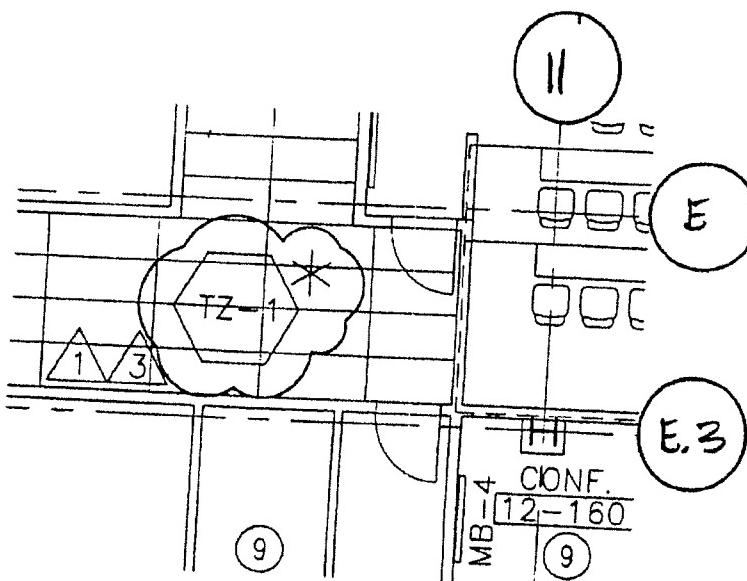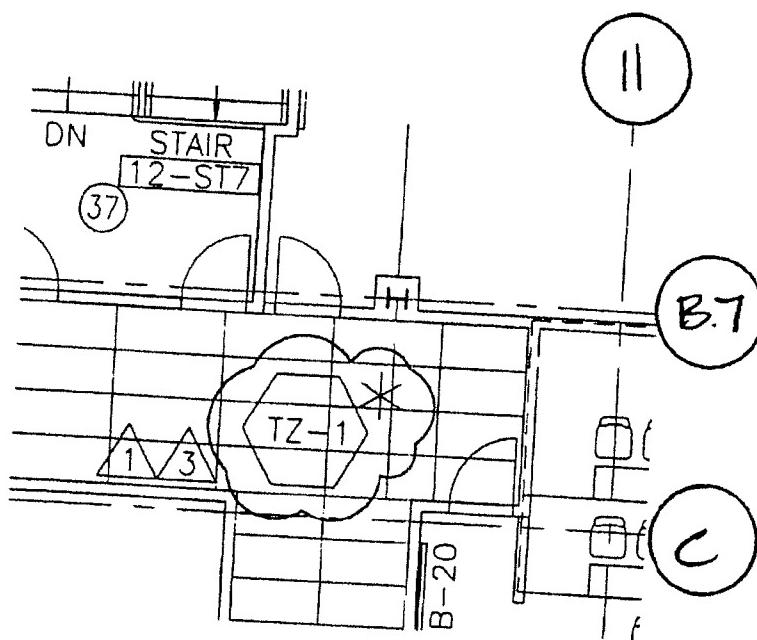

Baruch Academic Complex - Site B

55 LEXINGTON AVENUE NEW YORK, NY 10010

ARCHITECT
KPF ASSOCIATES

11 WEST 57TH STREET
NEW YORK, NY 10019



OWNER
DORMITORY AUTHORITY OF THE STATE OF NEW YORK, DA# 6500 1802 2178
1 PENNSYLVANIA PLAZA NEW YORK, NY 10119

REF. DETAIL/SHEET NO.

A-155

SKETCH NO.

NO.	REVISION	DATE	SCALE
3	ADDENDUM #2 (CONTRACT #16)	6/5/98	1/8" = 1'-0" SK-1338

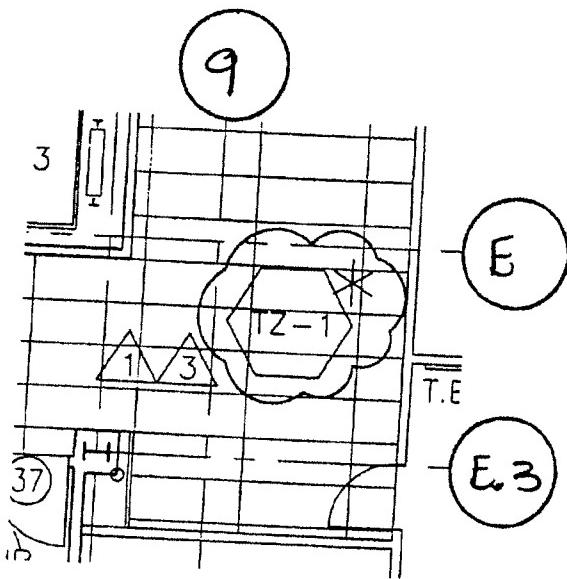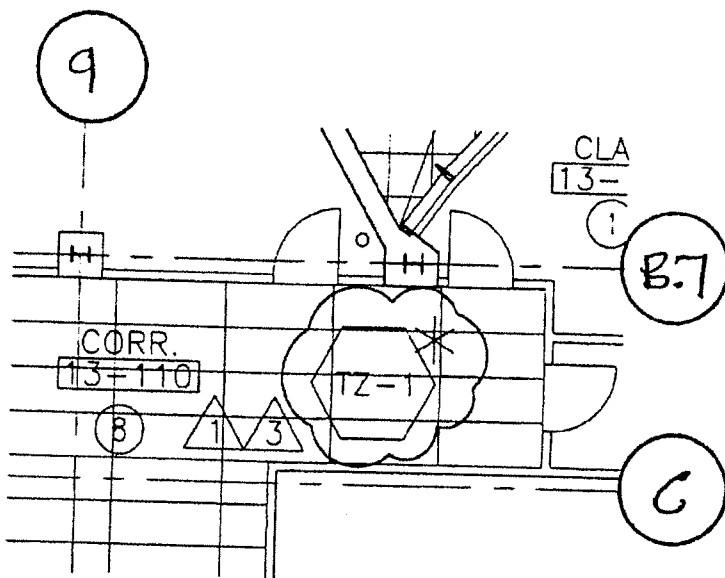

Baruch Academic Complex - Site B

55 LEXINGTON AVENUE NEW YORK, NY 10010

OWNER

DORMITORY AUTHORITY OF THE STATE OF NEW YORK, DA# 6500 1802 2178
1 PENNSYLVANIA PLAZA NEW YORK, NY 10119

ARCHITECT

KPF ASSOCIATES
11 WEST 57TH STREET
NEW YORK, NY 10019

REF. DETAIL/SHEET NO.

A - 156


SKETCH NO.

SK-1339

NO.	REVISION	DATE
2	ADDENDUM #2 (CONTRACT #16)	6/5/98

PTD. PROFILED METAL PANEL (CONTR. 15 TYP.) 2/1
SEE 300 SERIES DWG.S

FLUID APPLIED
RUBBERIZED ASPHALT
ROOFING MEMBRANE
SHOWN DOTTED

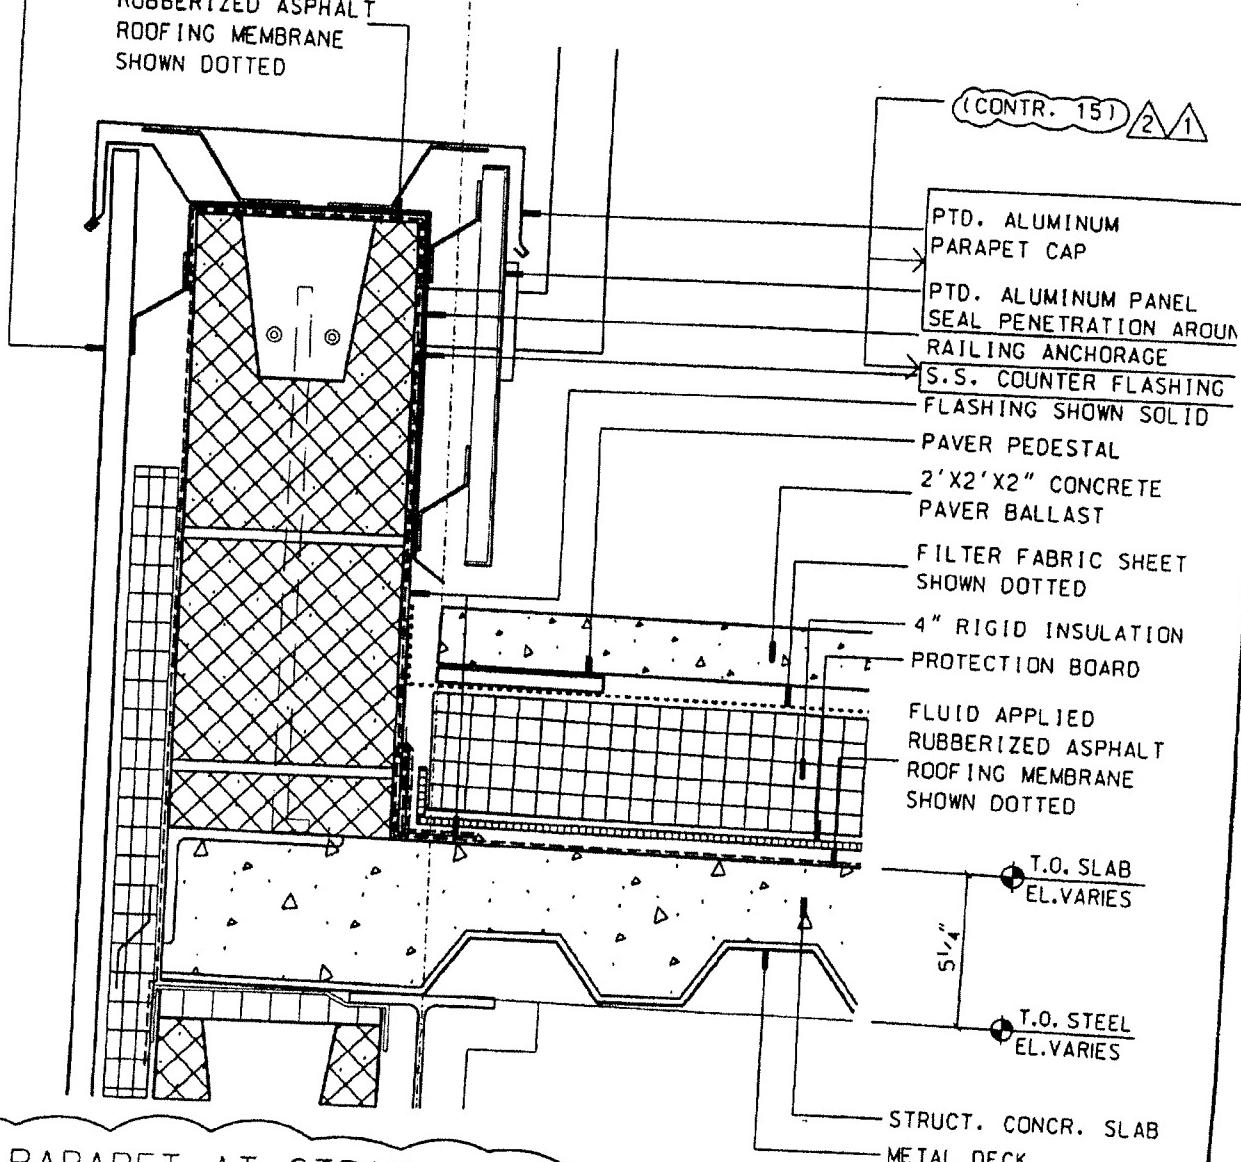

Baruch Academic Complex - Site B

55 LEXINGTON AVENUE
NEW YORK, NY 10010
OWNER
MUNICIPAL AUTHORITY OF THE STATE OF NEW YORK, DA# 6500 1802 2178
1 PENNSYLVANIA PLAZA
NEW YORK, NY 10119

ARCHITECT
KPF ASSOCIATES
11 WEST 57TH STREET
NEW YORK, NY 10019

REF. DETAIL/SHEET NO.	SKETCH NO.
11/A-250	SK-1340
SCALE	NTS

NO.


REVISION

DATE

ADDENDUM #2 (CONTRACT #16)

6/5/98

SEE 300 SERIES DWG.S
FOR WALL CONSTRUCTION
CONTINUOUS 24 GA. GALVANIZED
AIR BARRIER. CONTINUE OVER CURB.
PROVIDE 4" MINIMUM DOWNTURN
AND DOUBLESEAL TO BACK OF CURB (CONTR. #15) 2

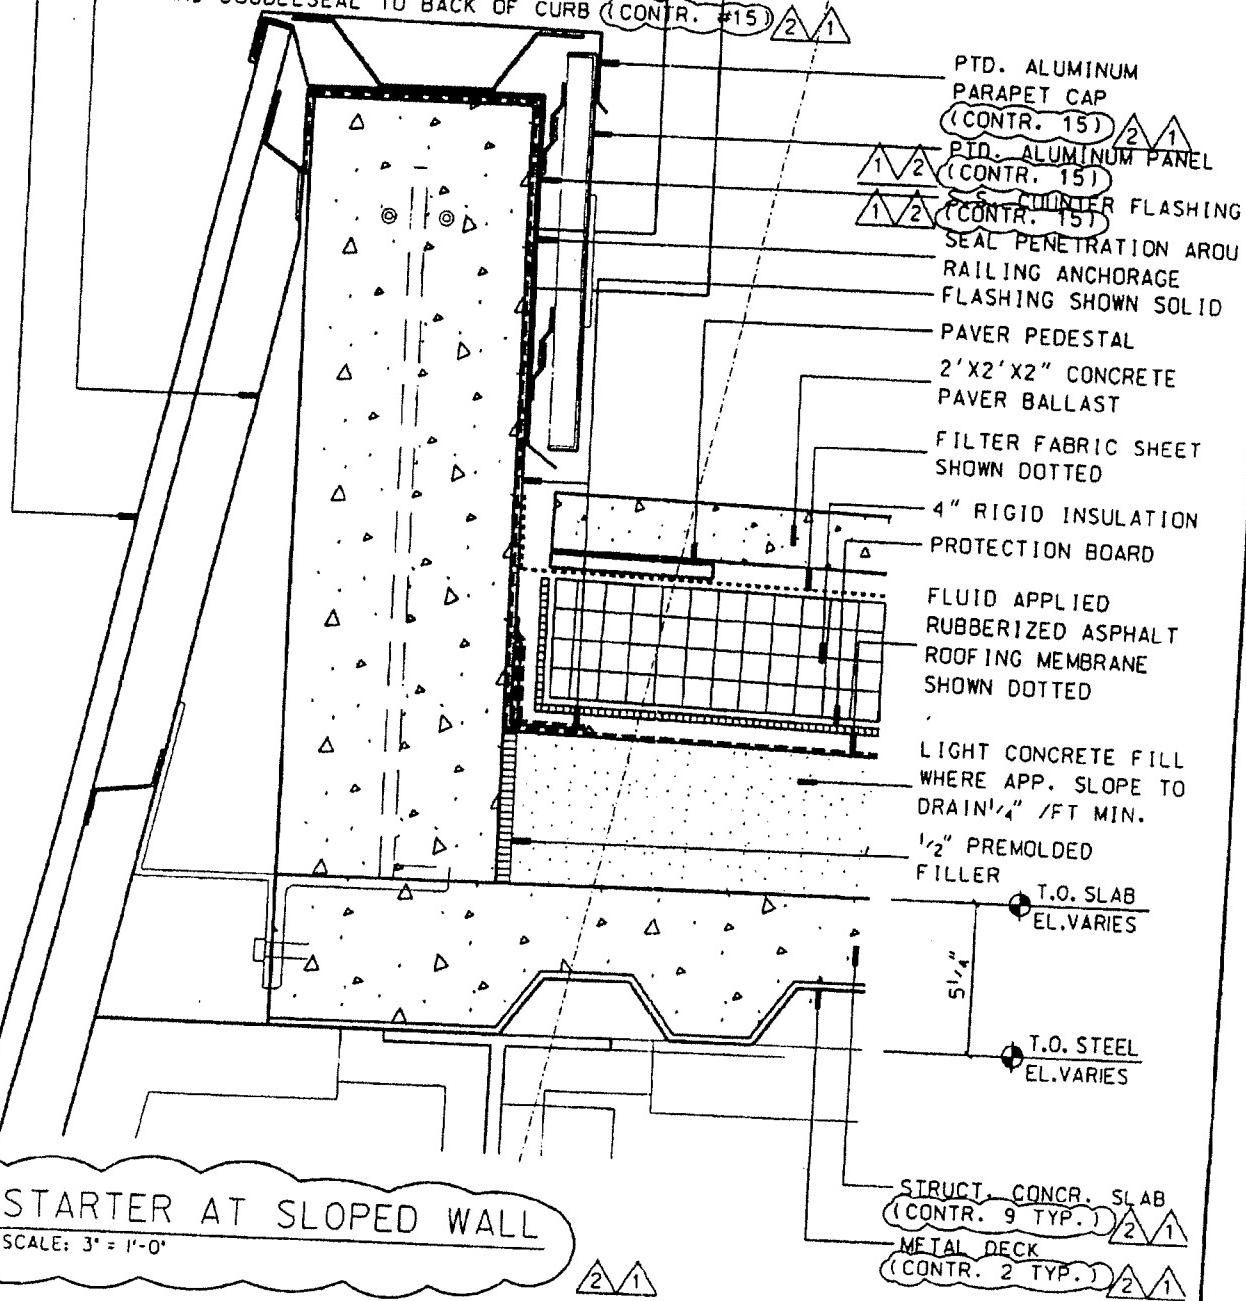

Baruch Academic Complex - Site B

55 LEXINGTON AVENUE

NEW YORK, NY 10010

ARCHITECT

KPF ASSOCIATES
11 WEST 57TH STREET
NEW YORK, NY 10019

OWNER
EDUCATIONAL AUTHORITY OF THE STATE OF NEW YORK, DA# 6500 1802 2178
1 PENNSYLVANIA PLAZA
NEW YORK, NY 10119

REF. DETAIL/SHEET NO.

12/A-250

SKETCH NO.

SCALE

NTS

SK-1341

NO.

REVISION

DATE

6/5/98

ADDENDUM #2 (CONTRACT #16)